

Hancock
M 2018
2-67

MISSISSIPPI
BOARD OF WATER COMMISSIONERS
416 North State Street
Jackson, Mississippi 39201

WATER WELL DRILLERS LOG

2-1 1967 date well completed
Better Well Works firm name
Hancock county well located

LANDOWNER: U.C. Bryant
6403 Lafaye St.
New Orleans La 70121
(mailing address)

description of formations encountered	from	to
Clay	0	10
sand	10	33
Clay	33	103
sand	103	128

WELL LOCATION:
sec. 12 T 9 S R 15 E
2 miles N of Lakesha
(distance) (direction) (nearest town)

WELL PURPOSE: Home
(home, irrigation, municipal, industrial)


WELL COMPLETION DATA:

- (1) diameter (inches) 2
- (2) total depth (feet) 128
- (3) static water level (feet) 9 below top of ground
- (4) casing galv. 123' (material) (depth)
- (5) screen 5' 123' (length) (depth to top)
- (6) pump 2" stainless steel (size) (material)
- (7) pump Unknown (HP) (yield gpm)

(type power)
(7) electric log No (yes or no)

(organization running log)
(8) how well bottom plugged BPO value

DRILLERS REMARKS:

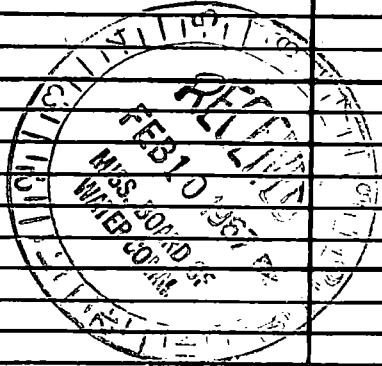

If well telescopes please sketch and show depths.

GROUND LEVEL

		X	

SECTION 1.2

Please indicate well location X.

ADDITIONAL INFORMATION

Handwritten notes and sketches in the additional information section, including the word "SAMPLE" written vertically in several places.

If more than one screen, show locations of each on sketch.