

Hancock
 M 7020
 8-68

MISSISSIPPI
 BOARD OF WATER COMMISSIONERS
 416 North State Street
 Jackson, Mississippi 39201

WATER WELL DRILLERS LOG

8-24 1968 Jutter Well Works Hancock
 date well completed firm name county well located

LANDOWNER: C.P. Schilling
 % Eddie Kreiger
 5708 Annunciation Street
 New Orleans La.
 (mailing address)

WELL LOCATION:
 sec 20 T 9 S R 14 E
 IN 5 Ansley Park W 6
 miles (distance) direction (nearest town)

WELL PURPOSE: home
 (home, irrigation, municipal, industrial)

WELL COMPLETION DATA:

- (1) diameter (inches) 2
- (2) total depth (feet) 156
- (3) static water level (feet) 1 below top of ground. above (flow)
- (4) casing Galv. 151' (material) (depth)
 2" (size) If telescope see back.
- (5) screen 5' 151' (length) (depth to top)
 2" (size) Stainless steel (material)
- (6) pump (HP) (yield gpm)
 (type power)
- (7) electric log no (yes or no)
 (organization running log)
- (8) how well bottom plugged B.P. Value

description of formations encountered	from	to
Clay	0	30
Sand	30	40
Clay	40	82
Sand	82	97
Clay	97	138
Sand	138	156


SEP 12 1968

MISS. Bd. OF WATER COMM.

DRILLERS REMARKS:

If well telescopes please sketch and show depths.

GROUND LEVEL

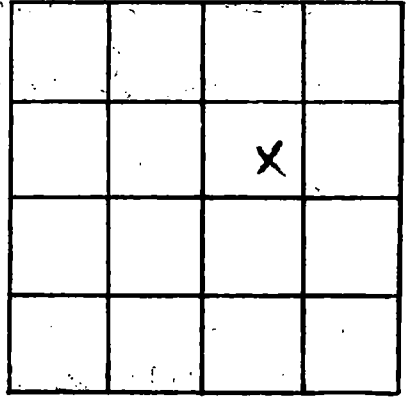

SECTION 20

Please indicate well location X.

ADDITIONAL INFORMATION

If more than one screen, show locations of each on sketch.