

MISSISSIPPI DEPARTMENT OF NATURAL RESOURCES

Bureau of Land and Water Resources

Southport Mall

P.O. Box 10631

Jackson, Mississippi 39209

WATER WELL DRILLERS LOG

HANCOCK
M 2021

Feb 26 1986 Ward Well Dlg Hancock
date well completed firm name county well located

LANDOWNER Anthony Stenrich
Rt. 7 Box 9
Bay St. Louis ms.
(mailing address)

| description of formations encountered | from | to |
|---------------------------------------|------------|------------|
| <u>Sandy clay</u> | <u>0</u> | <u>12</u> |
| <u>sd</u> | <u>12</u> | <u>44</u> |
| <u>clay w/shell</u> | <u>44</u> | <u>96</u> |
| <u>Case sd</u> | <u>96</u> | <u>128</u> |
| <u>clay - silty</u> | <u>129</u> | <u>160</u> |
| <u>Case sc - Red wood</u> | <u>160</u> | <u>182</u> |


WELL LOCATION:
sec 2 T 9 N R 15 E
3 miles N/W of Subahre
(distance) (direction) (nearest town)

WELL PURPOSE: Home
(home, irrigation, municipal, industrial)

WELL COMPLETION DATA:

- (1) diameter (inches) 2"
- (2) total depth (feet) 182'
- (3) static water level (feet) 10' below top of ground.
- (4) casing PVC, 172',
(material) (depth)
- If telescope see back.
(size)
- (5) screen 10', -
(length) (depth to top)
2", PVC
(size) (material)
- (6) pump owner -
(HP) (yield gpm)
-
(type power)
- (7) electric log NO
(yes or no)
N/A
(organization running log)
- (8) how well bottom plugged BWU

DRILLERS REMARKS: N/A

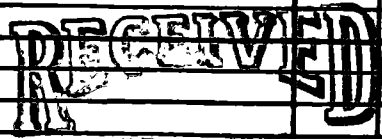

APR 11 1986

Department of Natural Resources
Bureau of Land & Water Resources

If well telescopes please sketch and show depths.

GROUND LEVEL

| | | | |
|--|--|--|---|
| | | | |
| | | | |
| | | | |
| | | | X |

SECTION 12

Please indicate well location X.

ADDITIONAL INFORMATION

If more than one screen,
show locations of each on sketch.