

HANCOCK
M 2023
2.23-76

MISSISSIPPI
 BOARD OF WATER COMMISSIONERS
 416 North State Street
 Jackson, Mississippi 39201

WATER WELL DRILLERS LOG

2-23- 1976 Ward Well Drilling Hancock
 date well completed firm name county well located


LANDOWNER	description of formations encountered	from	to
<u>Laurance Fontaine</u>	<u>Top Soil - Clay</u>	<u>0</u>	<u>16</u>
<u>Sasser Bay Rd.</u>	<u>Black sd.</u>	<u>16</u>	<u>42</u>
<u>Bay St. Louis, miss.</u>	<u>Grey Clay - Shell</u>	<u>42</u>	<u>96</u>
(mailing address)	<u>sd.</u>	<u>96</u>	<u>118</u>
	<u>Blue Clay - Silt</u>	<u>118</u>	<u>194</u>
	<u>sd.</u>	<u>194</u>	<u>236</u>

WELL LOCATION:
 sec. 13 T 9 N R 15 E
8 miles SW of B.S.L.
 (distance) (direction) (nearest town)

WELL PURPOSE: Dom.
 (home, irrigation, municipal, industrial)

- WELL COMPLETION DATA:
- (1) diameter (inches) 2"
 - (2) total depth (feet) 236
 - (3) static water level (feet) 7 Galley above top of ground.
 - (4) casing PVC, 231
 (material) (depth)
 (size) If telescope see back.
 - (5) screen 5', -
 (length) (depth to top)
2", PVC
 (size) (material)
 - (6) pump 1/2, 8
 (HP) (yield gpm)
Elec.
 (type power)
 - (7) electric log no.
 (yes or no)
N/A
 (organization running log)
 - (8) how well bottom plugged BWU

DRILLERS REMARKS: N/A

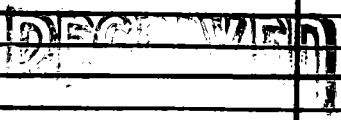

MAR 26 1976

