

HANCOK
Mississippi

MISSISSIPPI
BOARD OF WATER COMMISSIONERS
416 North State Street
Jackson, Mississippi 39201

WATER WELL DRILLERS LOG

3-17 1977 Woodwell Drilling Hancock
date well completed firm name county well located

Contract 9510001130


LANDOWNER: <u>L.P. Downey</u>		description of formations encountered	from	to
<u>14th Street</u>				
<u>Bay St. Louis, Miss</u> (mailing address)		<u>Sd</u>	<u>26</u>	<u>40</u>
WELL LOCATION:		<u>clay - shell</u>	<u>40</u>	<u>76</u>
sec. <u>28</u> T. <u>9</u> N. R. <u>14</u> E	<u>15</u>	<u>clay</u>	<u>76</u>	<u>105</u>
<u>7</u> miles <u>S/W</u> of <u>B.S.L.</u>	<u>3</u>	<u>fine sd</u>	<u>105</u>	<u>130</u>
(distance) (direction) (nearest town)		<u>clay - silt</u>	<u>130</u>	<u>141</u>
WELL PURPOSE: <u>Home</u> (home, irrigation, municipal, industrial)		<u>fine sd</u>	<u>141</u>	<u>166</u>
WELL COMPLETION DATA:		<u>clay - silt</u>	<u>166</u>	<u>250</u>
(1) diameter (inches) <u>2"</u>		<u>coarse - sd.</u>	<u>250</u>	<u>285</u>
(2) total depth (feet) <u>285</u>				
(3) static water level (feet) <u>1</u> <u>below</u> <u>above</u> top of ground.				
(4) casing <u>PVC</u> , <u>280</u> , (material) (depth)				
<u>-</u> if telescope see back. (size)				
(5) screen <u>5'</u> , <u>-</u> (length) (depth to top)				
<u>2"</u> , <u>PVC</u> (size) (material)				
(6) pump <u>1/2</u> , <u>8</u> (HP) (yield gpm)				
<u>elec.</u> (type power)				
(7) electric log <u>NO</u> (yes or no)				
<u>N/A</u> (organization running log)				
(8) how well bottom plugged <u>BWU</u>				
DRILLERS REMARKS: <u>N/A</u>				

RECEIVED
APR 26 1977

MISS. BD. OF WATER COMMISSIONERS

If well telescopes please sketch and show depths.

GROUND LEVEL

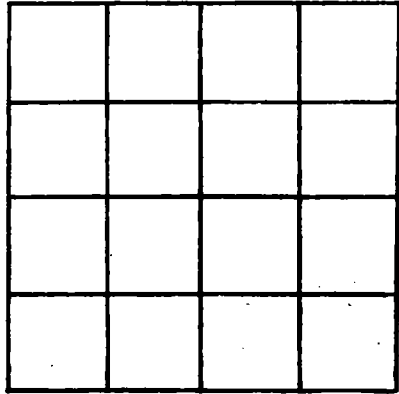

SECTION _____

Please indicate well location X.

ADDITIONAL INFORMATION

If more than one screen, show locations of each on sketch.