

HANCOCK
M 2032
6-15-77

MISSISSIPPI
 BOARD OF WATER COMMISSIONERS
 416 North State Street
 Jackson, Mississippi 39201

WATER WELL DRILLERS LOG

6-15- 1977 Wood Well Drilling Hancock
 date well completed firm name county well located

LANDOWNER: J. E. Bulakoven
Lower Bay Rd
Bay St. Louis, Miss.
 (mailing address)

WELL LOCATION:
 sec 7 T 9 N R 14 E
1/2 miles W of B.S.L.
 (distance) (direction) (nearest town)

WELL PURPOSE: Home
 (home, irrigation, municipal, industrial)

WELL COMPLETION DATA:

(1) diameter (inches) 2"

(2) total depth (feet) 335

(3) static water level (feet) 9 ^{below} _{above} top of ground.

(4) casing PVC, 325,
 (material) (depth)

- If telescope see back.
 (size)

(5) screen 10, -
 (length) (depth to top)

2", PVC
 (size) (material)

(6) pump none
 (HP) (yield gpm)

-
 (type power)

(7) electric log NO
 (yes or no)

N/A
 (organization running log)

(8) how well bottom plugged: BWD

description of formations encountered	from	to
<u>top soil - clay</u>	<u>0</u>	<u>19</u>
<u>sd</u>	<u>19</u>	<u>38</u>
<u>grey clay</u>	<u>38</u>	<u>80</u>
<u>clay - shell</u>	<u>80</u>	<u>96</u>
<u>sd</u>	<u>96</u>	<u>115</u>
<u>clay - silt</u>	<u>115</u>	<u>276</u>
<u>coral sc</u>	<u>276</u>	<u>335</u>


RECEIVED

JUL 20 1977

DRILLERS REMARKS: N/A

If well telescopes please sketch and show depths.

GROUND LEVEL

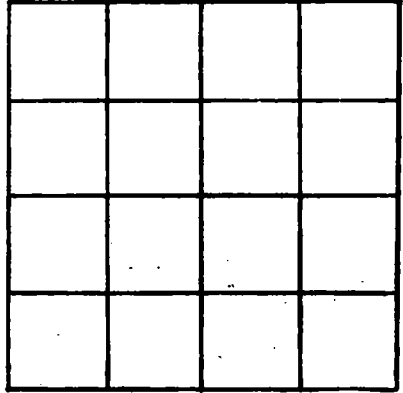

SECTION 2

Please indicate well location X.

ADDITIONAL INFORMATION

If more than one screen, show locations of each on sketch.