

HANCOCK
M 2037
6-16-80
6-16

MISSISSIPPI
 BOARD OF WATER COMMISSIONERS
 416 North State Street
 Jackson, Mississippi 39201

WATER WELL DRILLERS LOG

date well completed

firm name

county well located

1980 Wood Well Drilling Hancock

LANDOWNER: Eddie Hinton
Anselby Rd.
Bay St. Louis, Ms.
 (mailing address)

description of formations encountered	from	to
<u>Top Soil-clay</u>	<u>0</u>	<u>21</u>
<u>S&S</u>	<u>21</u>	<u>48</u>
<u>clay-shell</u>	<u>48</u>	<u>87</u>
<u>clay</u>	<u>87</u>	<u>145</u>
<u>Red Shell-S&S</u>	<u>145</u>	<u>167</u>
<u>clay-shell</u>	<u>167</u>	<u>280</u>
<u>Coaker S&S</u>	<u>280</u>	<u>310</u>

WELL LOCATION:
 sec. 28 T. 9 N. R. 14 E. 15 W.
20 miles S/W of Bay St. Louis
 (distance) (direction) (nearest town)

WELL PURPOSE: Home
 (home, irrigation, municipal, industrial)

- WELL COMPLETION DATA:
- (1) diameter (inches) 2"
 - (2) total depth (feet) 310
 - (3) static water level (feet) 10 ^{below} _{above} top of ground.
 - (4) casing PVC 300
 (material) (depth)
 — If telescope see back.
 (size)
 - (5) screen 10' —
 (length) (depth to top)
2" PVC
 (size) (material)
 - (6) pump owner
 (HP) (yield gpm)
 —
 (type power)
 - (7) electric log NO
 (yes or no)
N/A
 (organization running log)
 - (8) how well bottom plugged BWV

DRILLERS REMARKS: —


DEPT. OF NATURAL RESOURCES
 BUREAU OF LAND & WATER RESOURCES

JUL 21 1980

RECEIVED

If well telescopes please sketch and show depths.

GROUND LEVEL

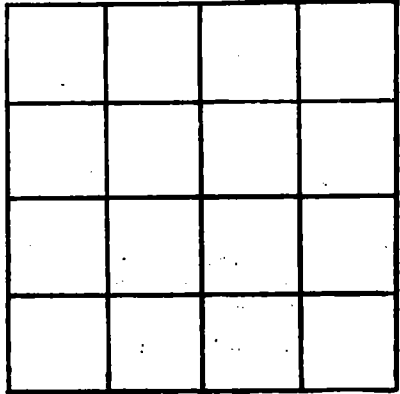

SECTION 28

Please indicate well location X.

ADDITIONAL INFORMATION

If more than one screen, show locations of each on sketch.