

**Harcock**  
 M 20399

MISSISSIPPI DEPARTMENT OF NATURAL RESOURCES  
 Bureau of Land and Water Resources  
 Southport Mall  
 P.O. Box 10631  
 Jackson, Mississippi 39209  
**WATER WELL DRILLERS LOG**

8-20-1980 date well completed  
 80 Ward Hill Dlg. firm name  
 Harcock county well located

LANDOWNER: Charles E. Milford  
East Hinds St.  
Boy St. Louis, ms.  
 (mailing address)

| description of formations encountered | from | to  |
|---------------------------------------|------|-----|
| Clay                                  | 0    | 18  |
| SD                                    | 18   | 42  |
| Clay Washell                          | 42   | 95  |
| Coarse SD                             | 95   | 130 |
| Clay                                  | 130  | 170 |
| Red gravel                            | 170  | 174 |
| Clay - Silt                           | 174  | 240 |
| Coarse SD                             | 240  | 270 |

WELL LOCATION:  
 sec. 6 T. 9 N. R. 14 E  
 (distance) miles (direction) of (nearest town)  
1/4 miles W of B.S. La.

WELL PURPOSE: Home  
 (home, irrigation, municipal, industrial)

- WELL COMPLETION DATA:
- (1) diameter (inches) 2"
  - (2) total depth (feet) 270
  - (3) static water level (feet) 10 <sup>below</sup> top of ground.
  - (4) casing PVC, 260  
 (material), (depth)  
 (size) If telescope see back.
  - (5) screen 10, -  
 (length), (depth to top)  
2", PVC  
 (size), (material)
  - (6) pump owner, -  
 (HP), (yield gpm)  
 (type power)
  - (7) electric log NO  
 (yes or no)  
N/A  
 (organization running log)
  - (8) how well bottom plugged BWV

DRILLERS REMARKS: N/A


DEPT. OF NATURAL RESOURCES  
 BUREAU OF LAND & WATER RESOURCES

SEP 10 1980

**RECEIVED**

If well telescopes please sketch and show depths.

GROUND LEVEL

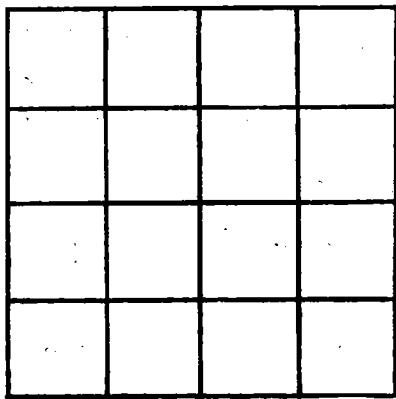

SECTION 6

Please indicate well location X.

ADDITIONAL INFORMATION

If more than one screen, show locations of each on sketch.