

**MISSISSIPPI  
BOARD OF WATER COMMISSIONERS**  
416 North State Street  
Jackson, Mississippi 39201

**WATER WELL DRILLERS LOG**

Hancock  
M 20-101  
4-23-81  
4-23 1981  
date well completed

Wardwell Dlg.  
firm name

Hancock  
county well located

LANDOWNER: Mike Daumer  
East Markin  
Ornelly, Mr.  
(mailing address)

description of formations encountered	from	to
	<u>Clay</u>	<u>0</u>
<u>SS</u>	<u>15</u>	<u>42</u>
<u>Clay</u>	<u>42</u>	<u>105</u>
<u>SS</u>	<u>105</u>	<u>147</u>

WELL LOCATION:  
sec 33 T 10 N R 15 E  
③ ④  
(distance) miles (direction) of (nearest town)

WELL PURPOSE: Comp  
(home, irrigation, municipal, industrial)

- WELL COMPLETION DATA:
- (1) diameter (inches) 2"
  - (2) total depth (feet) 147
  - (3) static water level (feet) 1 <sup>below</sup>/<sub>above</sub> top of ground.
  - (4) casing PVC 137  
(material) (depth)  
— if telescope see back.  
(size)
  - (5) screen 10 —  
(length) (depth to top)  
2" PVC  
(size) (material)
  - (6) pump Ornelly  
(HP) (yield gpm)  
—  
(type power)
  - (7) electric log NO  
(yes or no)  
N/A  
(organization running log)
  - (8) how well bottom plugged BWU


DRILLERS REMARKS: N/A

DEPT. OF NATURAL RESOURCES  
BUREAU OF LAND & WATER RESOURCES

JUN 2 - 1981  
**RECEIVED**

If well telescopes please sketch and show depths.

GROUND LEVEL

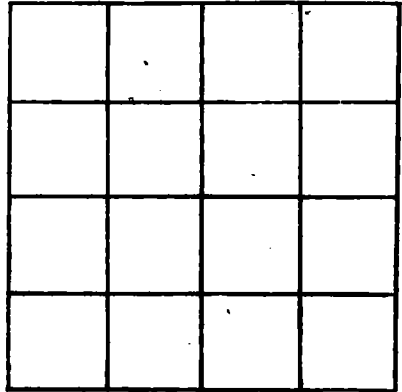

SECTION 33

Please indicate well location X.

ADDITIONAL INFORMATION

If more than one screen, show locations of each on sketch.