

HANCOCK  
M 2040  
7-22-81

MISSISSIPPI  
BOARD OF WATER COMMISSIONERS  
416 North State Street  
Jackson, Mississippi 39201

WATER WELL DRILLERS LOG

7-22-1981 date well completed  
81 Ward Well Drg. firm name  
Hancock county well located

LANDOWNER: <u>Louis Arhona Jr.</u> <u>Lake Shore Rd.</u>	description of formations encountered	from	to
<u>Lake Shore, ms.</u> (mailing address)	<u>Top Soil - clay</u>	0	18
WELL LOCATION: sec. <u>24</u> T. <u>9</u> N. R. <u>14</u> E <u>1</u> miles <u>S/E</u> of <u>Lake Shore</u> (distance) (direction) (nearest town)	<u>clay - shell</u>	18	36
WELL PURPOSE: <u>camp</u> (home, irrigation, municipal, industrial)	<u>clay - silt</u>	36	72
WELL COMPLETION DATA: (1) diameter (inches) <u>2</u> "	<u>clay - silt</u>	72	97
(2) total depth (feet) <u>270</u>	<u>sd</u>	97	115
(3) static water level (feet) <u>10</u> <u>below</u> above top of ground.	<u>sd</u>	115	252
(4) casing <u>PVC</u> <u>260</u> (material) (depth)		252	270
(5) screen <u>10</u> <u>-</u> (length) (depth to top)			
(6) pump <u>1/2</u> <u>10</u> (HP) (yield gpm)			
(7) electric log <u>no</u> (yes or no)			
(8) how well bottom plugged <u>N/A</u> (organization running log)			
DRILLERS REMARKS: <u>N/A</u>			




If well telescopes please sketch and show depths.

GROUND LEVEL


SECTION 24

Please indicate well location X.

ADDITIONAL INFORMATION

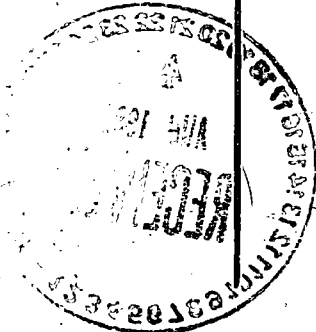

If more than one screen, show locations of each on sketch.