


HANCOCK  
M 20204  
8-4-81

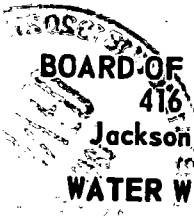

MISSISSIPPI  
BOARD OF WATER COMMISSIONERS  
416 North State Street  
Jackson, Mississippi 39201

WATER WELL DRILLERS LOG

8-4 1981 used well log Hancock  
date well completed firm name county well located

LANDOWNER: Thomas Burke  
West Gulf Rd.  
Bay St. Louis ms.  
(mailing address)

WELL LOCATION:  
sec 33 T 9 N R 15 E  
5 miles S/W of Anselmy  
(distance) (direction) (nearest town)

WELL PURPOSE: Camp  
(home, irrigation, municipal, industrial)

- WELL COMPLETION DATA:
- (1) diameter (inches) 2"
  - (2) total depth (feet) 165
  - (3) static water level (feet) 4 <sup>below</sup> ~~above~~ top of ground.
  - (4) casing PVC 155  
(material) (depth)
  - (size) If telescope see back.
  - (5) screen 10"   
(length) (depth to top)  
2" PVC  
(size) (material)
  - (6) pump owner -  
(HP) (yield gpm)
  - (type power)
  - (7) electric log NO  
(yes or no)  
N/A  
(organization running log)
  - (8) how well bottom plugged BWV

description of formations encountered	from	to
fill - clay	0	18
sd	18	42
clay	42	108
sd	108	126
clay	126	145
Red level - sd	145	165


DEPT. OF NATURAL RESOURCES  
BUREAU OF LAND & WATER RESOURCES

SEP 10 1981

RECEIVED

DRILLERS REMARKS: N/A

If well telescopes please sketch and show depths.

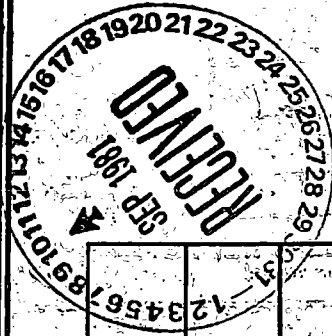

GROUND LEVEL


SECTION 33

Please indicate well location X.

ADDITIONAL INFORMATION

If more than one screen, show locations of each on sketch.