

MISSISSIPPI DEPARTMENT OF NATURAL RESOURCES

Bureau of Land and Water Resources

Southport Mall

P.O. Box 10631

Jackson, Mississippi 39209

WATER WELL DRILLERS LOG

Hancock
M 2058

9-23 1982
date well completed

82 Wardwell Dr.
firm name

Hancock
county well located

LANDOWNER: Ed Bourgeois
7 + 11 St.
Dearlington, ms.
(mailing address)

description of formations encountered	from	to
	Clay	0
sd	16	38
clay	38	60
Red gravel	60	72
clay	72	98
sd	98	110

WELL LOCATION:
sec. 19 T 9 N R. 15 E
1 miles N of Dearlington
(distance) (direction) (nearest town)

WELL PURPOSE: Home
(home, irrigation, municipal, industrial)

WELL COMPLETION DATA:

(1) diameter (inches) 2"

(2) total depth (feet) 110'

(3) static water level (feet) 10 ^{below}/_{above} top of ground.

(4) casing PVC, 100,
(material) (depth)
- if telescope see back.
(size)

(5) screen 10', -
(length) (depth to top)
2", PVC
(size) (material)

(6) pump owner
(HP) (yield gpm)
-
(type power)

(7) electric log NO
(yes or no)
N/A
(organization running log)

(8) how well bottom plugged BWU

DRILLERS REMARKS: N/A


DEPT. OF NATURAL RESOURCES
BUREAU OF LAND & WATER RESOURCES

OCT 27 1982

RECEIVED

If well telescopes please sketch and show depths.

GROUND LEVEL

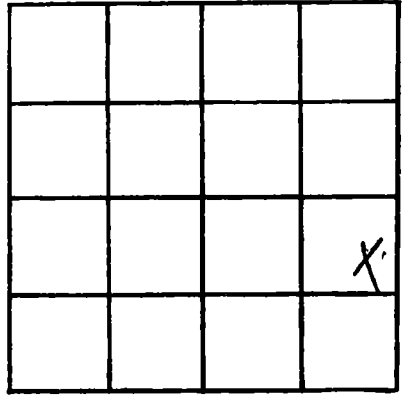

SECTION 19

Please indicate well location X.

ADDITIONAL INFORMATION

If more than one screen,
show locations of each on sketch.