

MISSISSIPPI DEPARTMENT OF NATURAL RESOURCES

Bureau of Land and Water Resources

Southport Mall

P.O. Box 10631

Jackson, Mississippi 39209

WATER WELL DRILLERS LOG

Hancock
M 2059

11-18- 19 82 Woodwell Dly. Hancock
date well completed firm name county well located

LANDOWNER	description of formations encountered	depth	
		from	to
<u>John Strawbridge</u>	<u>fill - clay</u>	<u>0</u>	<u>12</u>
<u>West Blvd.</u>	<u>sd</u>	<u>12</u>	<u>32</u>
<u>Bay St. Louis, ms.</u>	<u>clay</u>	<u>32</u>	<u>85</u>
(mailing address)	<u>sd</u>	<u>85</u>	<u>96</u>
WELL LOCATION:	<u>sd</u>	<u>96</u>	<u>127</u>
sec. <u>6</u> T. <u>9</u> N. R. <u>14</u> E.	<u>clay</u>	<u>127</u>	<u>152</u>
<u>10</u> miles <u>W</u> of <u>B.S.L.</u>	<u>Red Shale - sd</u>	<u>152</u>	<u>165</u>
(distance) (direction) (nearest town)			

WELL PURPOSE: Home
(home, irrigation, municipal, industrial)

- WELL COMPLETION DATA:
- (1) diameter (inches) 2"
 - (2) total depth (feet) 165'
 - (3) static water level (feet) 10 ^{below} ~~above~~ top of ground.
 - (4) casing PVC, 155'
(material) (depth)
- if telescope see back.
(size)
 - (5) screen 10', -
(length) (depth to top)
2", PVC
(size) (material)
 - (6) pump owner
(HP) (yield gpm)
-
(type power)
 - (7) electric log NO
(yes or no)
N/A
(organization running log)
 - (8) how well bottom plugged BWV

DRILLERS REMARKS: Sec. Bay Dile
Paul J. J. J.


DEPT. OF NATURAL RESOURCES
BUREAU OF LAND & WATER RESOURCES

JAN - 7 1983

RECEIVED

If well telescopes please sketch and show depths.

GROUND LEVEL

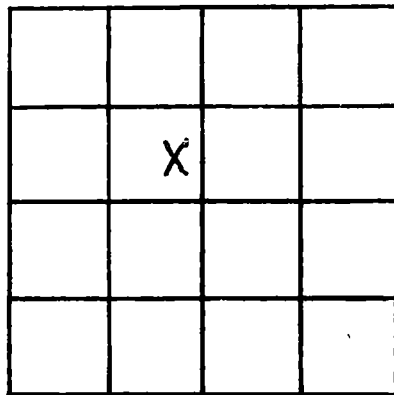

SECTION 6

Please indicate well location X.

ADDITIONAL INFORMATION

If more than one screen,
show locations of each on sketch.