

MISSISSIPPI DEPARTMENT OF NATURAL RESOURCES

Bureau of Land and Water Resources

Southport Mall

P.O. Box 10631

Jackson, Mississippi 39209

WATER WELL DRILLERS LOG

Hancock
M 20
61

12-8-1982 date well completed 82 Ward Well Drg. firm name Hancock county well located

LANDOWNER: Bob Keener
Bay St. Louis, Mo.
 (mailing/address)

description of formations encountered	from	to
<u>fill - clay</u>	<u>0</u>	<u>18</u>
<u>sd</u>	<u>18</u>	<u>46</u>
<u>clay</u>	<u>46</u>	<u>105</u>
<u>crs sd</u>	<u>105</u>	<u>128</u>
<u>clay - fill</u>	<u>128</u>	<u>147</u>
<u>red sand - sd</u>	<u>147</u>	<u>165</u>

WELL LOCATION:
 sec 6 T 9 N R 15
8 miles W of Wardland
 (distance) (direction) (nearest town)

WELL PURPOSE: None
 (home, irrigation, municipal, industrial)

WELL COMPLETION DATA:

(1) diameter (inches) 2"

(2) total depth (feet) 165'

(3) static water level (feet) 10 below top of ground

(4) casing PVC, 155'
 (material) (depth)
- If telescope see back.
 (size)

(5) screen 10', -
 (length) (depth to top)
2", PVC
 (size) (material)

(6) pump 1/2, 10
 (HP) (yield gpm)
Elec.
 (type power)

(7) electric log NO
 (yes or no)
WIT
 (organization running log)

(8) how well bottom plugged BWV

DRILLERS REMARKS: Sand Bay
Side Park Subv.


DEPT. OF NATURAL RESOURCES
 BUREAU OF LAND & WATER RESOURCES

JAN 21 1983

RECEIVED

If well telescopes please sketch and show depths.

GROUND LEVEL

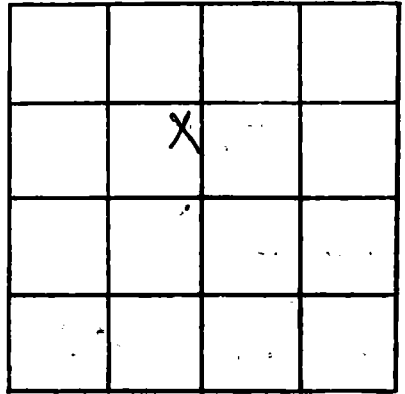

SECTION 8

Please indicate well location X.

ADDITIONAL INFORMATION

If more than one screen,
show locations of each on sketch.