

MISSISSIPPI DEPARTMENT OF NATURAL RESOURCES

Bureau of Land and Water Resources

Southport Mall

P.O. Box 10631

Jackson, Mississippi 39209

WATER WELL DRILLERS LOG

Hancock
M 2067
2067

12-27- 1982 Ward Well Drg. Hancock
 date well completed firm name county well located

LANDOWNER: Jeff Ebermann
Rt. 2, Box 611
Bay St. Louis, ms.
 (mailing address)

description of formations encountered	from	to
<u>fill - clay</u>	<u>0</u>	<u>18</u>
<u>sd</u>	<u>18</u>	<u>46</u>
<u>clay</u>	<u>46</u>	<u>98</u>
<u>sd</u>	<u>98</u>	<u>126</u>
<u>clay</u>	<u>126</u>	<u>148</u>
<u>Red Shovel - sd</u>	<u>148</u>	<u>170</u>

WELL LOCATION:
 sec. 6 T. 9 N. R. 15 E
7 miles W of Warland
 (distance) (direction) (nearest town)

WELL PURPOSE: Home
 (home, irrigation, municipal, industrial)

WELL COMPLETION DATA:

(1) diameter (inches) 2"

(2) total depth (feet) 170

(3) static water level (feet) 10 ^{below} _{above} top of ground.

(4) casing PVC, 160,
 (material) (depth)
— if telescope see back.
 (size)

(5) screen 10', —
 (length) (depth to top)
2", PVC
 (size) (material)

(6) pump 1/2, 10
 (HP) (yield gpm)
Elec.
 (type power)

(7) electric log NO
 (yes or no)
N/A
 (organization running log)

(8) how well bottom plugged BWV

DRILLERS REMARKS: Log in
Bay Side Park Sub.


DEPT. OF NATURAL RESOURCES
 BUREAU OF LAND & WATER RESOURCES

JAN 31 1983

RECEIVED

If well telescopes please sketch and show depths.

GROUND LEVEL

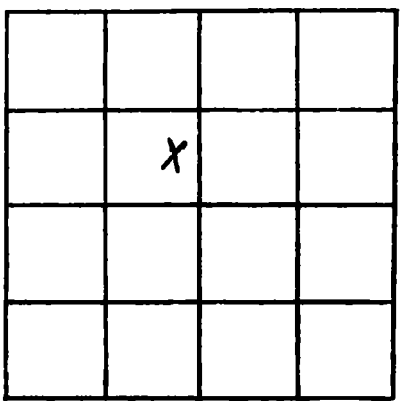

SECTION 6

Please indicate well location X.

ADDITIONAL INFORMATION

A series of horizontal lines for writing additional information.

If more than one screen, show locations of each on sketch.