

MISSISSIPPI DEPARTMENT OF NATURAL RESOURCES

Bureau of Land and Water Resources

Southport Mall

P.O. Box 10631

Jackson, Mississippi 39209

WATER WELL DRILLERS LOG

Hancock
M 2063

1-4- 1983 Ward Well Dlg Hancock
date well completed firm name county well located

LANDOWNER: <u>Patrick Peltit</u> <u>Rt. 2 Box 666K2</u> <u>Bay St. Louis, ms.</u> (mailing address)	description of formations encountered	from	to
		<u>Top Soil - clay</u>	<u>0</u>
	<u>sd</u>	<u>12</u>	<u>36</u>
	<u>clay</u>	<u>36</u>	<u>75</u>
	<u>sd</u>	<u>75</u>	<u>86</u>
	<u>clay</u>	<u>86</u>	<u>105</u>
	<u>sd</u>	<u>105</u>	<u>127</u>
	<u>clay</u>	<u>127</u>	<u>138</u>
	<u>Red Shale - sd</u>	<u>138</u>	<u>160</u>

WELL LOCATION:
sec. 6 T. 9 N. R. 18 E
6 miles W of Waveland
(distance) (direction) (nearest town)

WELL PURPOSE: Home
(home, irrigation, municipal, industrial)

- WELL COMPLETION DATA:
- (1) diameter (inches) 2"
 - (2) total depth (feet) 160
 - (3) static water level (feet) 10 below top of ground. above
 - (4) casing PVC 150
(material) (depth)
(size) If telescope see back.
 - (5) screen 10' -
(length) (depth to top)
2" PVC
(size) (material)
 - (6) pump owner -
(HP) (yield gpm)
(type power)
 - (7) electric log no
(yes or no)
NIA
(organization running log)
 - (8) how well bottom plugged BWU

DRILLERS REMARKS: NIA


DEPT. OF NATURAL RESOURCES
BUREAU OF LAND & WATER RESOURCES

MAR - 4 1983

RECEIVED

If well telescopes please sketch and show depths.

GROUND LEVEL

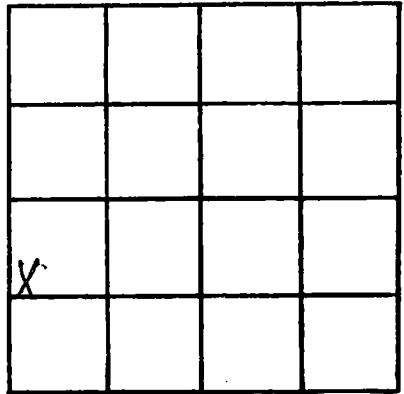

SECTION 6

Please indicate well location X.

ADDITIONAL INFORMATION

If more than one screen,
show locations of each on sketch.