

MISSISSIPPI DEPARTMENT OF NATURAL RESOURCES

Bureau of Land and Water Resources

Southport Mall

P.O. Box 10631

Jackson, Mississippi 39209

WATER WELL DRILLERS LOG

Hancock  
M 2065

2-9 1983 Ward Well Drilling Hancock  
date well completed firm name county well located

LANDOWNER: J.C. Walkwell  
Forest St.  
Bay St. Louis, ms  
(mailing address)

description of formations encountered	from	to
	<u>Top Soil - clay</u>	<u>0</u>
<u>sd</u>	<u>18</u>	<u>45</u>
<u>Clay - silt</u>	<u>45</u>	<u>102</u>
<u>sd</u>	<u>102</u>	<u>128</u>
<u>Clay</u>	<u>128</u>	<u>147</u>
<u>Red Shale - sd</u>	<u>147</u>	<u>170</u>

WELL LOCATION:  
sec. 6 T 9 N R 15 E  
12 miles W of Waveland  
(distance) (direction) (nearest town)

WELL PURPOSE: None  
(home, irrigation, municipal, industrial)


- WELL COMPLETION DATA:
- (1) diameter (inches) 2"
  - (2) total depth (feet) 170
  - (3) static water level (feet) 11 <sup>below</sup> <sub>above</sub> top of ground.
  - (4) casing PVC, 160,  
(material) (depth)  
         if telescope see back.  
(size)
  - (5) screen 10',           
(length) (depth to top)  
2", PVC  
(size) (material)
  - (6) pump owner,           
(HP) (yield gpm)  
          
(type power)
  - (7) electric log NO  
(yes or no)  
N/A  
(organization running log)
  - (8) how well bottom plugged BWU

DRILLERS REMARKS: N/A

DEPT. OF NATURAL RESOURCES  
BUREAU OF LAND AND WATER RESOURCES  
MAR 2 1983  
**RECEIVED**

If well telescopes please sketch and show depths.

GROUND LEVEL

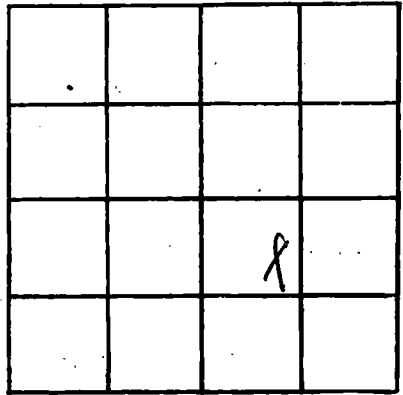

SECTION 6

Please indicate well location X.

ADDITIONAL INFORMATION

If more than one screen, show locations of each on sketch.