

MISSISSIPPI DEPARTMENT OF NATURAL RESOURCES

Bureau of Land and Water Resources

Southport Mall

P.O. Box 10631

Jackson, Mississippi 39209

WATER WELL DRILLERS LOG

Hancock
M 206

3-1- 1983
 date well completed

Wood Well Drg.
 firm name

Hancock
 county well located

LANDOWNER: Bruce McMan
P.O. Box 483
Waveland, ms.
 (mailing address)

description of formations encountered	from	to
	<u>fill - clay</u>	<u>0</u>
<u>sd</u>	<u>21</u>	<u>44</u>
<u>clay</u>	<u>44</u>	<u>96</u>
<u>Red sand - sd</u>	<u>96</u>	<u>125</u>

WELL LOCATION:
 sec 23 T 9 N R 14 E
4 miles S/W of Jackson
 (distance) (direction) (nearest town)

WELL PURPOSE: Home
 (home, irrigation, municipal, industrial)

- WELL COMPLETION DATA:
- (1) diameter (inches) 2"
 - (2) total depth (feet) 125
 - (3) static water level (feet) 4 ^{below} ~~above~~ top of ground.
 - (4) casing PVC, 115,
 (material) (depth)
 (size) If telescope see back.
 - (5) screen 10', -
 (length) (depth to top)
2", PVC
 (size) (material)
 - (6) pump owner
 (HP) (yield gpm)
 (type power)
 - (7) electric log NO
 (yes or no)
N/A
 (organization running log)
 - (8) how well bottom plugged BWV


DRILLERS REMARKS:

DEPT. OF NATURAL RESOURCES
 BUREAU OF LAND & WATER RESOURCES

APR 22 1983
RECEIVED

If well telescopes please sketch and show depths.

GROUND LEVEL

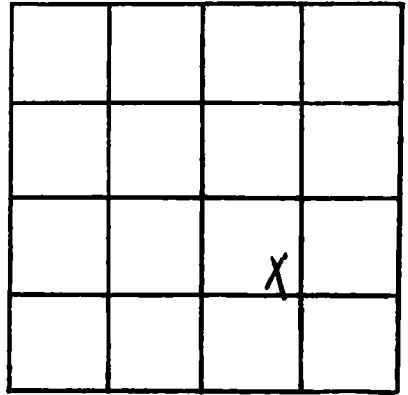

SECTION 23

Please indicate well location X.

ADDITIONAL INFORMATION

If more than one screen, show locations of each on sketch.