

MISSISSIPPI DEPARTMENT OF NATURAL RESOURCES

Bureau of Land and Water Resources

Southport Mall

P.O. Box 10631

Jackson, Mississippi 39209

WATER WELL DRILLERS LOG

Hancock
M 2068

4-1 1983 Wood Well Drg. Hancock
date well completed firm name county well located

LANDOWNER	description of formations encountered	from	to
<u>Walter Spide</u>	<u>top soil - clay</u>	<u>0</u>	<u>15</u>
<u>Walshall St.</u>	<u>sd</u>	<u>15</u>	<u>45</u>
<u>Bay St. Lorie m.</u>	<u>clay-shell</u>	<u>45</u>	<u>96</u>
(mailing address)	<u>sd</u>	<u>96</u>	<u>125</u>
WELL LOCATION:	<u>Clay-silt</u>	<u>125</u>	<u>152</u>
sec. <u>6</u> T. <u>9</u> N. R. <u>14</u> E.	<u>Red gravel - sd</u>	<u>152</u>	<u>178</u>
<u>12</u> miles <u>S/W</u> of <u>Warland</u>			
(distance) (direction) (nearest town)			
WELL PURPOSE: <u>Home</u>			
(home, irrigation, municipal, industrial)			
WELL COMPLETION DATA:			
(1) diameter (inches) <u>2"</u>			
(2) total depth (feet) <u>178</u>			
(3) static water level (feet) <u>10</u> <u>below</u> top of ground.			
(4) casing <u>PVC</u> <u>168</u>			
(material) (depth)			
(size) if telescope see back.			
(5) screen <u>10'</u> <u>2"</u>			
(length) (depth to top) (size) (material)			
(6) pump <u>—</u> <u>—</u>			
(HP) (yield gpm)			
(type power)			
(7) electric log <u>NO</u>			
(yes or no)			
(organization running log) <u>N/A</u>			
(8) how well bottom plugged <u>BWD</u>			
DRILLERS REMARKS: <u>N/A</u>			


MISSISSIPPI DEPARTMENT OF NATURAL RESOURCES
BUREAU OF LAND & WATER RESOURCES

MAY 26 1983

RECEIVED

If well telescopes please sketch and show depths.

GROUND LEVEL

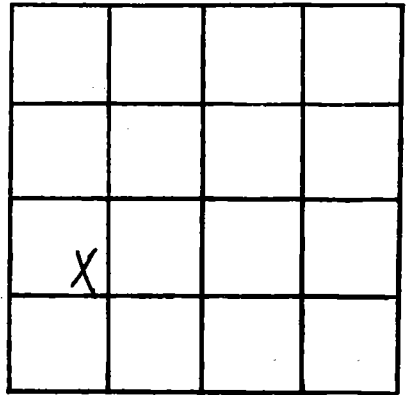

SECTION 6

Please indicate well location X.

ADDITIONAL INFORMATION

A series of horizontal lines for writing additional information.

If more than one screen, show locations of each on sketch.