

MISSISSIPPI DEPARTMENT OF NATURAL RESOURCES

Bureau of Land and Water Resources

Southport Mall

P.O. Box 10631

Jackson, Mississippi 39209

WATER WELL DRILLERS LOG

Hancock
M 2069

4-12- 1983
date well completed

Ward Well Dlg.
firm name

Hancock
county well located

LANDOWNER:	description of formations encountered	from	to
<u>Blades Hernandez</u> <u>Pt. 2 Box 615 A</u>	<u>fill - clay</u>	<u>0</u>	<u>14</u>
<u>Bay St. Sorie, Inc.</u> (mailing address)	<u>sd</u>	<u>14</u>	<u>36</u>
	<u>clay</u>	<u>36</u>	<u>56</u>
	<u>clay w/ shell</u>	<u>56</u>	<u>95</u>
	<u>sd</u>	<u>95</u>	<u>125</u>
	<u>clay</u>	<u>125</u>	<u>148</u>
	<u>red gravel - sd</u>	<u>148</u>	<u>168</u>

WELL LOCATION:

sec. 6 T. 8 N. R. 14 E.
12 miles S/W of Warland
(distance) (direction) (nearest town)

WELL PURPOSE: Home
(home, irrigation, municipal, industrial)

WELL COMPLETION DATA:

- (1) diameter (inches) 2
- (2) total depth (feet) 168
- (3) static water level (feet) 10 ^{below}/_{above} top of ground.
- (4) casing PVC, 158
(material) (depth)
2 (size) If telescope see back.
- (5) screen 10', -
(length) (depth to top)
2", PVC
(size) (material)
- (6) pump -, -
(HP) (yield gpm)
- (type power)
- (7) electric log NO
(yes or no)
N/A
(organization running log)
- (8) how well bottom plugged BWD

DRILLERS REMARKS: N/A


DEPT. OF NATURAL RESOURCES
BUREAU OF LAND & WATER RESOURCES

MAY 26 1983

RECEIVED

If well telescopes please sketch and show depths.

GROUND LEVEL

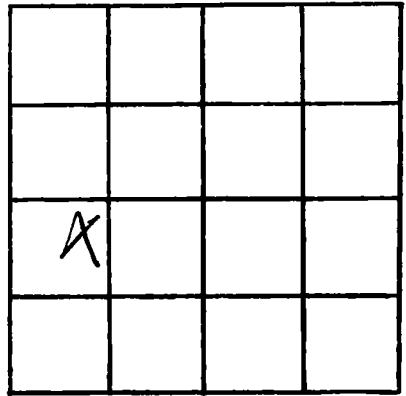

SECTION 6

Please indicate well location X.

ADDITIONAL INFORMATION

A series of horizontal lines for writing additional information.

If more than one screen, show locations of each on sketch.