

MISSISSIPPI DEPARTMENT OF NATURAL RESOURCES

Bureau of Land and Water Resources

Southport Mall

P.O. Box 10631

Jackson, Mississippi 39209

WATER WELL DRILLERS LOG

Hancock
M 206570

4-15- 1983 ward well ply Hancock
date well completed firm name county well located

LANDOWNER: Faye West
Forest & Lake St,
Bay St. Louis, ms,
(mailing address)

description of formations encountered	from to	
<u>Top Soil - clay</u>	<u>0</u>	<u>15</u>
<u>sd</u>	<u>15</u>	<u>42</u>
<u>Clay</u>	<u>42</u>	<u>96</u>
<u>sd</u>	<u>96</u>	<u>126</u>
<u>Clay</u>	<u>126</u>	<u>152</u>
<u>Red Shale - sd</u>	<u>152</u>	<u>168</u>

WELL LOCATION:
sec. 6 T. 8 N. R. 14 E.
11 miles S/W of Bay St. Louis
(distance) (direction) (nearest town)

WELL PURPOSE: Home
(home, irrigation, municipal, industrial)

WELL COMPLETION DATA:

(1) diameter (Inches) 2"

(2) total depth (feet) 168

(3) static water level (feet) 10 below top of ground.

(4) casing PVC 158
(material) (depth)
(size) If telescope see back.

(5) screen 10 -
(length) (depth to top)
2" PVC
(size) (material)

(6) pump - -
(HP) (yield gpm)
(type power)

(7) electric log NO
(yes or no)
N/A
(organization running log)

(8) how well bottom plugged BWU

DRILLERS REMARKS: N/A


DEPT. OF NATURAL RESOURCES
BUREAU OF LAND & WATER RESOURCES

MAY 26 1983

RECEIVED

If well telescopes please sketch and show depths.

GROUND LEVEL

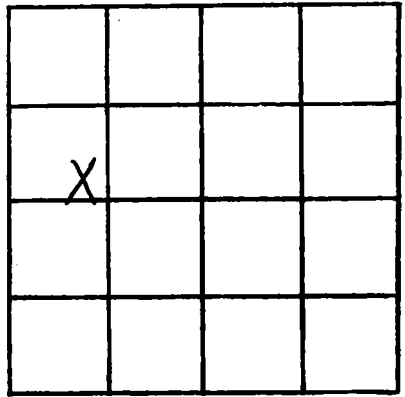

SECTION 6

Please indicate well location X.

ADDITIONAL INFORMATION

If more than one screen,
show locations of each on sketch.