

MISSISSIPPI DEPARTMENT OF NATURAL RESOURCES

Bureau of Land and Water Resources

Southport Mall

P.O. Box 10631

Jackson, Mississippi 39209

WATER WELL DRILLERS LOG

Hancock
M 2078

4-13 1983 Wood Well Dr Hancock
 date well completed firm name county well located

LANDOWNER:	description of formations encountered.	from	to
<u>Beany's Air Cond. & Heating</u> <u>Lower Bay Rd.</u>	<u>Top Soil - Clay</u>	<u>0</u>	<u>15</u>
<u>Bay St. Scrie ms.</u> (mailing address)	<u>clay</u>	<u>15</u>	<u>44</u>
	<u>sd</u>	<u>44</u>	<u>96</u>
	<u>sd</u>	<u>96</u>	<u>127</u>
	<u>clay</u>	<u>127</u>	<u>210</u>
	<u>sd</u>	<u>210</u>	<u>227</u>
	<u>clay</u>	<u>227</u>	<u>268</u>
	<u>core sd</u>	<u>268</u>	<u>298</u>

WELL LOCATION: 15
 sec. 7 T. 9 N. R. 14 E. W
13 miles SW Woodland
 (distance) (direction) (nearest town)

WELL PURPOSE: Home
 (home, irrigation, municipal, industrial)

- WELL COMPLETION DATA:
- (1) diameter (inches) 2"
 - (2) total depth (feet) 298
 - (3) static water level (feet) 10 ^{below} _{above} top of ground.
 - (4) casing PVC, 288,
 (material) (depth)
 - (size) if telescope see back.
 - (5) screen 10', -
 (length) (depth to top)
 - 2", PVC
 (size) (material)
 - (6) pump -, -
 (HP) (yield gpm)
 - (type power)
 - (7) electric log NO
 (yes or no)
 - N/A
 (organization running log)
 - (8) how well bottom plugged BWU

DRILLERS REMARKS: N/A


DEPT. OF NATURAL RESOURCES
 BUREAU OF LAND & WATER RESOURCES

MAY 26 1983

RECEIVED

If well telescopes please sketch and show depths.

GROUND LEVEL

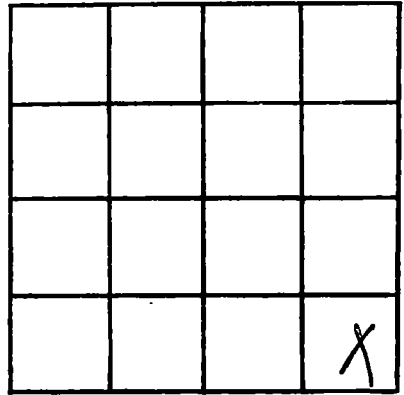

SECTION 2

Please indicate well location X.

ADDITIONAL INFORMATION

If more than one screen,
show locations of each on sketch.