

MISSISSIPPI DEPARTMENT OF NATURAL RESOURCES

Bureau of Land and Water Resources

Southport Mall

P.O. Box 10631

Jackson, Mississippi 39209

WATER WELL DRILLERS LOG

Hancock
MA 2074

5-6 1983 Ward Well Drg Hancock
date well completed firm name county well located

LANDOWNER: Mary Deleaux
West Jackson
Bay St. Louis mo.
(mailing address)

WELL LOCATION:
sec. 6 T. 9 N. R. 14 E.
14 miles SW of B.S.L.
(distance) (direction) (nearest town)

WELL PURPOSE: Home
(home, irrigation, municipal, industrial)

WELL COMPLETION DATA:

(1) diameter (Inches) 2"

(2) total depth (feet) 273

(3) static water level (feet) 10 below top of ground.

(4) casing PVC, 263
(material) (depth)
2" If telescope see back.
(size)

(5) screen 10', -
(length) (depth to top)
2", PVC
(size) (material)

(6) pump 1/2, 10
(HP) (yield gpm)
Elco
(type power)

(7) electric log NO
(yes or no)
N/A
(organization running log)

(8) how well bottom plugged BWU

| description of formations encountered | from | to |
|---------------------------------------|------------|------------|
| <u>Fill-clay</u> | <u>0</u> | <u>18</u> |
| <u>Sd</u> | <u>18</u> | <u>45</u> |
| <u>Clay</u> | <u>45</u> | <u>102</u> |
| <u>Sd</u> | <u>102</u> | <u>128</u> |
| <u>Clay</u> | <u>128</u> | <u>154</u> |
| <u>Red Shale-Sd</u> | <u>154</u> | <u>176</u> |
| <u>Clay-Silt</u> | <u>176</u> | <u>256</u> |
| <u>Coarse Sd</u> | <u>256</u> | <u>273</u> |

DRILLERS REMARKS: N/A


DEPT. OF NATURAL RESOURCES
BUREAU OF LAND & WATER RESOURCES

JUN 17 1983

RECEIVED

If well telescopes please sketch and show depths.

GROUND LEVEL

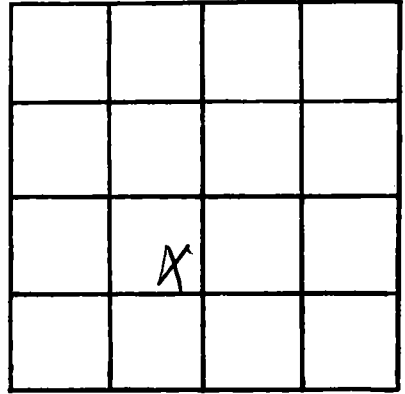

SECTION 6

Please indicate well location X.

ADDITIONAL INFORMATION

If more than one screen,
show locations of each on sketch.