

MISSISSIPPI DEPARTMENT OF NATURAL RESOURCES
Bureau of Land and Water Resources
 Southport Mall
 P.O. Box 10631
 Jackson, Mississippi 39209
WATER WELL DRILLERS LOG

Hancock
M 27786

5-11 1983 Mc Gill Wall Works HANCOCK
 date well completed firm name county well located

LANDOWNER: Everett Darrow
Pl. #4 Box 1163
Box St. Louis, Ms.
 (mailing address)

WELL LOCATION:
 sec 11 T 8 N R 10 E
 S W
1.2 miles SW of Bisil
 (distance) (direction) (nearest town)

WELL PURPOSE: None
 (home, irrigation, municipal, industrial)

- WELL COMPLETION DATA:
- (1) diameter (inches) 2"
- (2) total depth (feet) 525'
- (3) static water level (feet) 25' below ~~about~~ top of ground.
- (4) casing Sch 40 PVC, 515'
 (material) (depth)
- if telescope see back.
 (size)
- (5) screen 10', 515'
 (length) (depth to top)
2", 80 PVC 6 slot
 (size) (material)
- (6) pump (HP) (yield gpm)
elec
 (type power)
- (7) electric log -
 (yes or no)

 (organization running log)
- (8) how well bottom plugged deal


description of formations encountered	from	to
Mud	0	20
hard	20	40
Sand	40	60
hard	60	80
Mud	80	210
Sand	300	350
Mud	350	410
Sand	410	450
Mud	450	470
Sand	470	480
Sand	480	500
Sand	500	520
Sand	520	525

DRILLERS REMARKS:

DEPT. OF NATURAL RESOURCES
 BUREAU OF LAND & WATER RESOURCES
 JAN 17 1984
RECEIVED

If well telescopes please sketch and show depths.

GROUND LEVEL

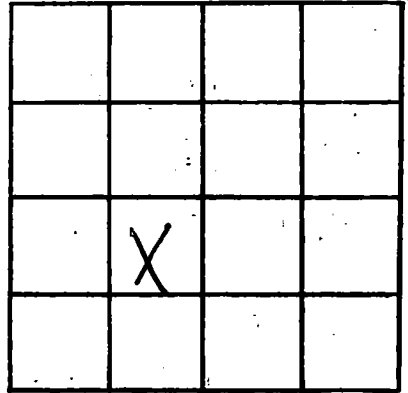

SECTION 11

Please indicate well location X.

ADDITIONAL INFORMATION

If more than one screen, show locations of each on sketch.