

MISSISSIPPI DEPARTMENT OF NATURAL RESOURCES

Bureau of Land and Water Resources

Southport Mall

P.O. Box 10631

Jackson, Mississippi 39209

WATER WELL DRILLERS LOG

Hancock
M 20707

May 19 1983 Duncan Well Drilling Hancock
 date well completed firm name county well located

| LANDOWNER: <u>Elizabeth Hughes</u> | description of formations encountered | | from | to |
|---|---------------------------------------|--|------------|------------|
| <u>Rt. 2 Box 609</u> | | | | |
| <u>Bay St. Louis Ms</u> (mailing address) | <u>Clay</u> | | <u>0</u> | <u>10</u> |
| | <u>sand</u> | | <u>10</u> | <u>50</u> |
| | <u>Blue clay</u> | | <u>50</u> | <u>95</u> |
| | <u>Clay & Sand</u> | | <u>95</u> | <u>135</u> |
| | <u>course sand</u> | | <u>135</u> | <u>189</u> |
| WELL LOCATION: soc. <u>18</u> T. <u>10</u> N. R. <u>15</u> E. <u>5</u> miles <u>SW</u> of <u>Waveland</u> (distance) (direction) (nearest town) | | | | |
| WELL PURPOSE: <u>Home</u> (home, irrigation, municipal, industrial) | | | | |
| WELL COMPLETION DATA: (1) diameter (inches) <u>2"</u> (2) total depth (feet) <u>189 ft</u> (3) static water level (feet) <u>10'</u> ^{below} above top of ground. (4) casing <u>PVC</u> , <u>179'</u> (material) (depth) (size) If telescope see back. (5) screen <u>10'</u> , <u>179'</u> (length) (depth to top) <u>2"</u> , <u>PVC</u> (size) (material) (6) pump _____ (HP) _____ (yield gpm) (type power) _____ (7) electric log _____ (yes or no) (organization running log) _____ (8) how well bottom plugged _____ | | | | |
| DRILLERS REMARKS: <u>owner had their own pump</u> | | | | |


DEPT. OF NATURAL RESOURCES
 BUREAU OF LAND & WATER RESOURCES

AUG 15 1983

RECEIVED

If well telescopes please sketch and show depths.

GROUND LEVEL

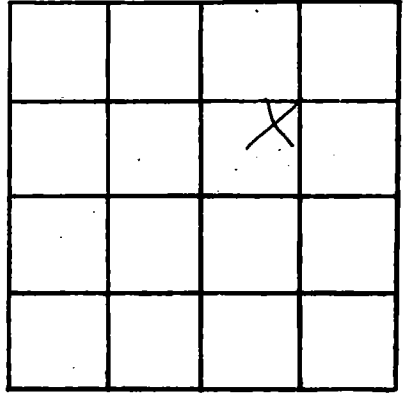

SECTION 18

Please indicate well location X.

ADDITIONAL INFORMATION

If more than one screen,
show locations of each on sketch.