

MISSISSIPPI DEPARTMENT OF NATURAL RESOURCES

Bureau of Land and Water Resources

Southport Mall

P.O. Box 10631

Jackson, Mississippi 39209

WATER WELL DRILLERS LOG

Hancock  
M 2078

7-5- 1983 Wood Well Pkg. Hancock  
date well completed firm name county well located

LANDOWNER: Billy Sanders  
Hancock St.  
Boy St. Souie, Mrs.  
(mailing address)

description of formations encountered	from	to
	<u>Top Soil - Clay</u>	<u>0</u>
<u>sd</u>	<u>12</u>	<u>38</u>
<u>clay</u>	<u>38</u>	<u>96</u>
<u>sd</u>	<u>96</u>	<u>128</u>
<u>clay</u>	<u>128</u>	<u>152</u>
<u>sd - Red gravel</u>	<u>152</u>	<u>170</u>

WELL LOCATION:  
sec. 6 T. 9 N. R. 14 E.  
12 miles S/W of B.S.L.  
(distance) (direction) (nearest town)

WELL PURPOSE: Home  
(home, irrigation, municipal, industrial)

- WELL COMPLETION DATA:
- (1) diameter (inches) 2"
  - (2) total depth (feet) 170
  - (3) static water level (feet) 10 below top of ground. above
  - (4) casing PVC, 160,  
(material) (depth)  
- If telescope see back.  
(size)
  - (5) screen 10', -  
(length) (depth to top)  
2", PVC  
(size) (material)
  - (6) pump owner, -  
(HP) (yield gpm)  
- (type power)
  - (7) electric log NO  
(yes or no)  
N/A  
(organization running log)
  - (8) how well bottom plugged BWU

DRILLERS REMARKS: N/A


DEPT. OF NATURAL RESOURCES  
BUREAU OF LAND & WATER RESOURCES

AUG 17 1983

RECEIVED

If well telescopes please sketch and show depths.

GROUND LEVEL

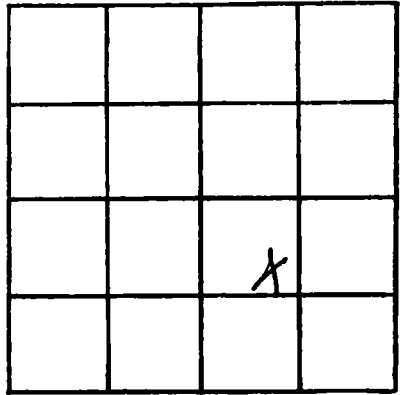

SECTION 6

Please indicate well location X.

ADDITIONAL INFORMATION

A series of horizontal lines for writing additional information, starting below the 'ADDITIONAL INFORMATION' header and extending to the bottom of the page.

If more than one screen, show locations of each on sketch.