

MISSISSIPPI DEPARTMENT OF NATURAL RESOURCES

Bureau of Land and Water Resources

Southport Mall

P.O. Box 10631

Jackson, Mississippi 39209

WATER WELL DRILLERS LOG

HANCOCK
M 2088

Mar. 17 1986 Wood Well Dr. Hancock
date well completed firm name county well located

LANDOWNER: Le Roy R. Curitt
Hancock & West Newton
Bay St. Louis, Ms.
(mailing address)

description of formations encountered	from	to
<u>Fill - clay</u>	<u>0</u>	<u>15</u>
<u>clay - silt</u>	<u>15</u>	<u>47</u>
<u>clay - silt</u>	<u>47</u>	<u>95</u>
<u>clay - silt</u>	<u>95</u>	<u>132</u>
<u>Red Shale - sd</u>	<u>132</u>	<u>148</u>

WELL LOCATION:
sec. 6 T. 9 N. R. 14 E.
13 miles W of B.S.L.
(distance) (direction) (nearest town)

WELL PURPOSE: Home
(home, irrigation, municipal, industrial)

- WELL COMPLETION DATA:
- (1) diameter (inches) 2"
 - (2) total depth (feet) 165'
 - (3) static water level (feet) 12 below above top of ground.
 - (4) casing PVC, 155'
(material) (depth)
- If telescope see back.
(size)
 - (5) screen 10', -
(length) (depth to top)
2", PVC
(size) (material)
 - (6) pump 1/2, 10
(HP) (yield gpm)
Elec.
(type power)
 - (7) electric log NO
(yes or no)
N/A
(organization running log)
 - (8) how well bottom plugged BW


DRILLERS REMARKS: N/A

RECEIVED
MAY 12 1986

Department of Natural Resources
Bureau of Land & Water Resources

If well telescopes please sketch and show depths.

GROUND LEVEL

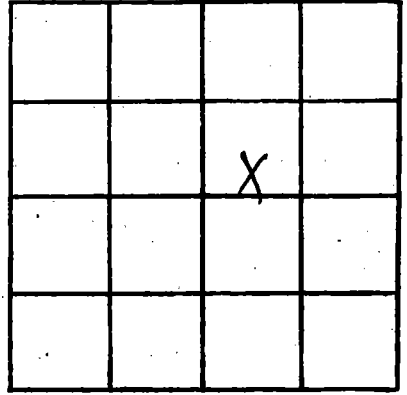

SECTION 6

Please indicate well location X.

ADDITIONAL INFORMATION

If more than one screen, show locations of each on sketch.