

HANCOCK
 M 20801
 4-15-76

MISSISSIPPI
 BOARD OF WATER COMMISSIONERS
 416 North State Street
 Jackson, Mississippi 39201


WATER WELL DRILLERS LOG

4-15-76
 date well completed

130 Wardwell Dr.
 firm name

Hancock
 county well located


LANDOWNER: <u>L. Prater</u>	description of formations encountered	from	to
<u>General Delivery</u>			
<u>Prichard, Miss.</u> (mailing address)	<u>sd</u>	<u>22</u>	<u>35</u>
	<u>clay</u>	<u>35</u>	<u>91</u>
	<u>sd</u>	<u>91</u>	<u>105</u>
	<u>clay</u>	<u>105</u>	<u>112</u>
	<u>sd</u>	<u>112</u>	<u>132</u>
WELL LOCATION:			
sec. <u>19</u> T <u>9</u> N R. <u>14</u> E			
<u>19</u> miles (distance) <u>W</u> (direction) of <u>B.S.L.</u> (nearest town)			
WELL PURPOSE: <u>Home</u> (home, irrigation, municipal, industrial)			
WELL COMPLETION DATA:			
(1) diameter (inches) <u>2</u>			
(2) total depth (feet) <u>132</u>			
(3) static water level (feet) <u>5</u> <u>below</u> top of ground.			
(4) casing <u>PVC</u> (material), <u>127</u> (depth)			
(size) <u>-</u> if telescope see back.			
(5) screen <u>5'</u> (length), <u>-</u> (depth to top)			
<u>2"</u> (size), <u>PVC</u> (material)			
(6) pump <u>owner</u> (HP), <u>-</u> (yield gpm)			
(type power) <u>-</u>			
(7) electric log <u>no</u> (yes or no)			
<u>N/A</u> (organization running log)			
(8) how well bottom plugged <u>BWU</u>			
DRILLERS REMARKS: <u>N/A</u>			

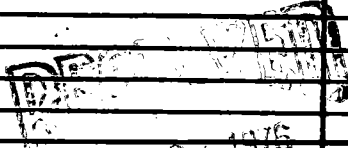

MISS. BD. OF WATER COMME

If well telescopes please sketch and show depths.

GROUND LEVEL

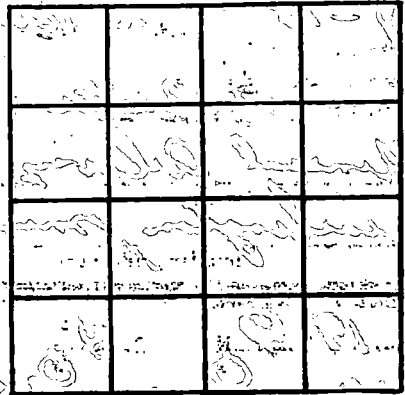

SECTION 12

Please indicate well location X.

ADDITIONAL INFORMATION

If more than one screen, show locations of each on sketch.