

MISSISSIPPI DEPARTMENT OF NATURAL RESOURCES

Bureau of Land and Water Resources

Southport Mall

P.O. Box 10631

Jackson, Mississippi 39209

WATER WELL DRILLERS LOG

Hancock
M 2085
2085

29 Aug. 1983 Wood Well Drg. Hancock
 date well completed firm name county well located

LANDOWNER Jack Arbute
Huron Bay Estate
Analy, Mrs.
 (mailing address)

description of formations encountered	from	to
<u>Fill - clay</u>	<u>0</u>	<u>15</u>
<u>sd</u>	<u>15</u>	<u>38</u>
<u>clay</u>	<u>38</u>	<u>96</u>
<u>sd</u>	<u>96</u>	<u>116</u>
<u>clay</u>	<u>116</u>	<u>127</u>
<u>Sand - Red Shovel</u>	<u>127</u>	<u>150</u>

WELL LOCATION:
 sec. 33 T 9 N R 15 E
5 miles S/W of Analy
 (distance) (direction) (nearest town)

WELL PURPOSE: Home
 (home, irrigation, municipal, industrial)

WELL COMPLETION DATA:

(1) diameter (inches) 2"

(2) total depth (feet) 150'

(3) static water level (feet) 2 below above top of ground.

(4) casing PVC, 140,
 (material) (depth)
- if telescope see back.
 (size)

(5) screen 10', -
 (length) (depth to top)
2", PVC
 (size) (material)

(6) pump owner, -
 (HP) (yield gpm)
-
 (type power)

(7) electric log NO
 (yes or no)
N/A
 (organization running log)

(8) how well bottom plugged BWV

DRILLERS REMARKS: N/A


DEPT. OF NATURAL RESOURCES
 BUREAU OF LAND & WATER RESOURCES

OCT 17 1983

RECEIVED

If well telescopes please sketch and show depths.

GROUND LEVEL

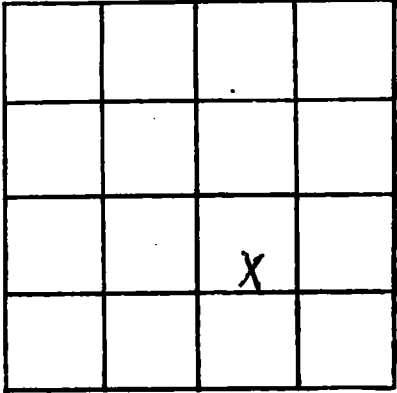

SECTION 33

Please indicate well location X.

ADDITIONAL INFORMATION

A series of horizontal lines for entering additional information.

If more than one screen, show locations of each on sketch.