

MISSISSIPPI DEPARTMENT OF NATURAL RESOURCES

Bureau of Land and Water Resources

Southport Mall

P.O. Box 10631

Jackson, Mississippi 39209

WATER WELL DRILLERS LOG

Hancock
M ~~2091~~
2091

11-4 1983 Gulf Coast Waterwell Hancock
date well completed firm name county well located

LANDOWNER Cheryl Gardner
West Denata St
Bay Side Park
(mailing address)

WELL LOCATION:
sec. 6 T. 9 R. 14
S W
3 miles West of Waveland
(distance) (direction) (nearest town)

WELL PURPOSE: Drainage
(home, irrigation, municipal, industrial)

WELL COMPLETION DATA:
(1) diameter (inches) 2
(2) total depth (feet) 135
(3) static water level (feet) 7 below above top of ground.
(4) casing PVC, 110
(material) (depth)
2 If telescope see back.
(size)
(5) screen 20', 110
(length) (depth to top)
2, PVC
(size) (material)
(6) pump 1 10
(HP) (yield gpm)
220 VAC
(type power)
(7) electric log NO
(yes or no)
(organization running log)
(8) how well bottom plugged Sand Shaker

description of formations encountered	from	to
		30
Clay		15
DK Green Sand	15	40
Clay	40	45
Sandy Clay	45	90
HARD KING SAND	90	98
good med sand	98	135

DEPT. OF NATURAL RESOURCES
BUREAU OF LAND & WATER RESOURCES


NOV - 8 1983

RECEIVED

DRILLERS REMARKS:

If well telescopes please sketch and show depths.

GROUND LEVEL

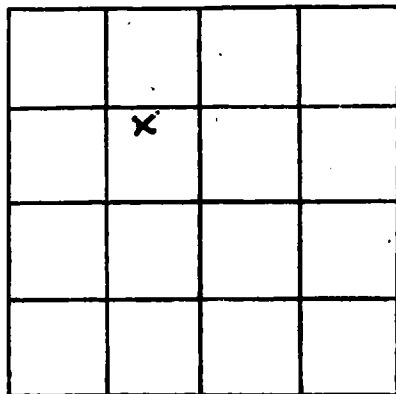

SECTION 6

Please indicate well location X.

ADDITIONAL INFORMATION

If more than one screen, show locations of each on sketch.