

MISSISSIPPI DEPARTMENT OF NATURAL RESOURCES

Bureau of Land and Water Resources

Southport Mall

P.O. Box 10631

Jackson, Mississippi 39209

WATER WELL DRILLERS LOG

Hancock  
M 2094

4-17-  
date well completed

1984 Wood Well Dlg.  
firm name

Hancock  
county well located

LANDOWNER: Junk Migliore  
Huron Bay Estate  
Amley, Mr.  
(mailing address)

description of formations encountered

from to

WELL LOCATION:  
sec. 4 T-9-10 N R-15 E  
4 miles SW of Amley  
(distance) (direction) (nearest town)

<u>Clay</u>	<u>0</u>	<u>34</u>
<u>sd</u>	<u>34</u>	<u>55</u>
<u>Clay</u>	<u>55</u>	<u>96</u>
<u>sd</u>	<u>96</u>	<u>115</u>
<u>Clay - silt</u>	<u>115</u>	<u>128</u>
<u>sd - pea gravel</u>	<u>128</u>	<u>150</u>

WELL PURPOSE: Camp  
(home, irrigation, municipal, industrial)

WELL COMPLETION DATA:

- (1) diameter (inches) 2"
- (2) total depth (feet) 150'
- (3) static water level (feet) 5 <sup>below</sup> above top of ground.
- (4) casing PVC 140  
(material) (depth)  
- If telescope see back.  
(size)
- (5) screen 10' -  
(length) (depth to top)  
2" PVC  
(size) (material)
- (6) pump - -  
(HP) (yield gpm)  
(type power)
- (7) electric log NO  
(yes or no)  
N/A  
(organization running log)
- (8) how well bottom plugged BWU

DEPT. OF NATURAL RESOURCES  
BUREAU OF LAND & WATER RESOURCES


MAY 25 1984

RECEIVED

DRILLERS REMARKS: N/A

If well telescopes please sketch and show depths.

GROUND LEVEL

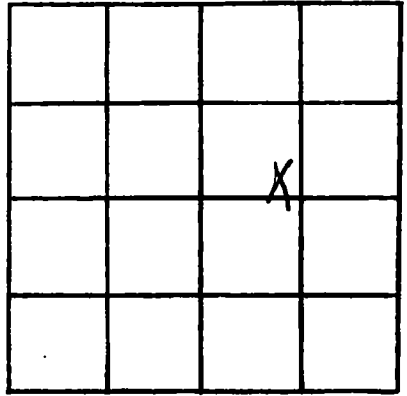

SECTION 4

Please indicate well location X.

ADDITIONAL INFORMATION

If more than one screen, show locations of each on sketch.