

MISSISSIPPI DEPARTMENT OF NATURAL RESOURCES

Bureau of Land and Water Resources

Southport Mall

P.O. Box 10631

Jackson, Mississippi 39209

WATER WELL DRILLERS LOG

Hancock  
M 20993

6-8-

date well completed

1984 Ward Well Dr.

firm name

Hancock

county well located

LANDOWNER: Clarence Bryan  
Rt. 2, Box 493A  
Bay St. Louis, ms.  
(mailing address)

description of formations encountered

from to

WELL LOCATION:  
sec. 6 T. 9 N. R. 14 E. S. 5  
13 miles W of B.S.L.  
(distance) (direction) (nearest town)

<u>Clay</u>	<u>0</u>	<u>10</u>
<u>sd</u>	<u>10</u>	<u>44</u>
<u>Clay</u>	<u>44</u>	<u>98</u>
<u>sd</u>	<u>98</u>	<u>131</u>
<u>Clay - silt</u>	<u>131</u>	<u>152</u>
<u>Red gravel - sd</u>	<u>152</u>	<u>168</u>

WELL PURPOSE: Home  
(home, irrigation, municipal, industrial)

WELL COMPLETION DATA:

(1) diameter (inches) 2"

(2) total depth (feet) 168

(3) static water level (feet) 12 below above top of ground.

(4) casing PVC, 158,  
(material) (depth)  
2" if telescope see back.  
(size)

(5) screen 10', -  
(length) (depth to top)  
2", PVC  
(size) (material)

(6) pump - -  
(HP) (yield gpm)  
- -  
(type power)

(7) electric log NO  
(yes or no)  
N/A  
(organization running log)

(8) how well bottom plugged BWV

DRILLERS REMARKS: N/A


DEPT. OF NATURAL RESOURCES  
BUREAU OF LAND & WATER RESOURCES

AUG 31 1984

RECEIVED

If well telescopes please sketch and show depths.

GROUND LEVEL

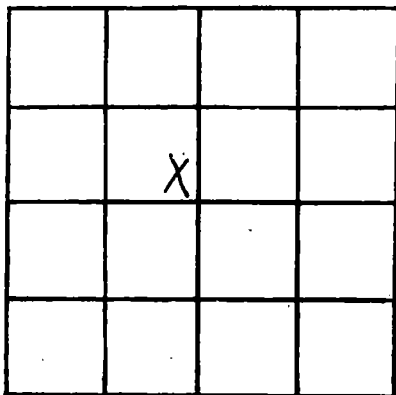

SECTION 6

Please indicate well location X.

ADDITIONAL INFORMATION

If more than one screen, show locations of each on sketch.