

**MISSISSIPPI DEPARTMENT OF NATURAL RESOURCES**  
**Bureau of Land and Water Resources**  
 Southport Mall  
 P.O. Box 10631  
 Jackson, Mississippi 39209  
**WATER WELL DRILLERS LOG**

Hancock  
M 70948

6-15- 1984 Ward Well Drg. Hancock  
 date well completed firm name county well located

LANDOWNER: Camilla J. Davis  
Pt. 2, Box 475 H  
Box St. Louis, Mo.  
 (mailing address)

description of formations encountered	from	to
	<u>Clay</u>	<u>0</u>
<u>Sd</u>	<u>18</u>	<u>46</u>
<u>Clay</u>	<u>46</u>	<u>105</u>
<u>Per shell - Sd</u>	<u>105</u>	<u>130</u>

WELL LOCATION:  
 sec. 3 T. 9 N. R. 15 E.  
10 miles W of Wardland  
 (distance) (direction) (nearest town)

WELL PURPOSE: None  
 (home, irrigation, municipal, industrial)

- WELL COMPLETION DATA:
- (1) diameter (inches) 2"
- (2) total depth (feet) 130'
- (3) static water level (feet) 10 below above top of ground.
- (4) casing PVC 120  
 (material) (depth)
- If telescope see back.  
 (size)
- (5) screen 10' -  
 (length) (depth to top)
- 2" PVC  
 (size) (material)
- (6) pump - -  
 (HP) (yield gpm)
- (type power)
- (7) electric log NO  
 (yes or no)  
N/A  
 (organization running log)
- (8) how well bottom plugged BWV

DRILLERS REMARKS: N/A


DEPT. OF NATURAL RESOURCES  
 BUREAU OF LAND & WATER RESOURCES

AUG 3 1984

**RECEIVED**

If well telescopes please sketch and show depths.

GROUND LEVEL

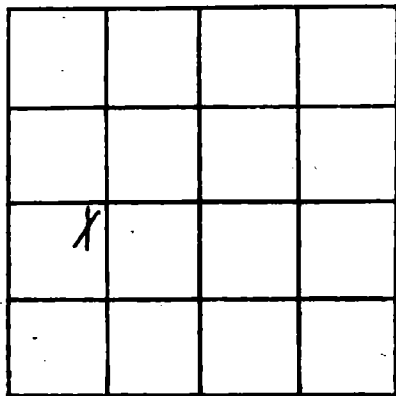

SECTION 3

Please indicate well location X.

ADDITIONAL INFORMATION

If more than one screen,  
show locations of each on sketch.