

MISSISSIPPI DEPARTMENT OF NATURAL RESOURCES
Bureau of Land and Water Resources
 Southport Mall
 P.O. Box 10631
 Jackson, Mississippi 39209
WATER WELL DRILLERS LOG

Hancock
M 2095

7-17- 1984 Wood Well Dlg. Hancock
 date well completed firm name county well located

LANDOWNER: Joyce Bauer
Rt. 7, Box 107
Box St. Louis mo.
 (mailing address)
 WELL LOCATION:
 sec. 6 T. 9 N R. 14 E
11 miles W of B.S.L.
 (distance) (direction) (nearest town)

description of formations encountered	from	to
	<u>fill-clay</u>	<u>0</u>
<u>clay-silt</u>	<u>12</u>	<u>45</u>
<u>clay-silt</u>	<u>45</u>	<u>105</u>
<u>clay-silt</u>	<u>105</u>	<u>132</u>
<u>clay-silt</u>	<u>132</u>	<u>152</u>
<u>clay-silt</u>	<u>152</u>	<u>167</u>
<u>clay-silt</u>	<u>167</u>	<u>216</u>
<u>clay-silt</u>	<u>216</u>	<u>245</u>

WELL PURPOSE: Drinking
 (home, irrigation, municipal, industrial)

WELL COMPLETION DATA:

- (1) diameter (inches) 2"
 (2) total depth (feet) 245
 (3) static water level (feet) 12 below above
 top of ground.
 (4) casing PVC, 235
 (material) (depth)

- if telescope see back.
 (size)

- (5) screen 10', -
 (length) (depth to top)
2", PVC
 (size) (material)

- (6) pump none, -
 (HP) (yield gpm)
-
 (type power)

- (7) electric log NO
 (yes or no)
N/A
 (organization running log)

- (8) how well bottom plugged BWU

DRILLERS REMARKS: N/A


DEPT. OF NATURAL RESOURCES
 BUREAU OF LAND & WATER RESOURCES

SEP - 4 1984

RECEIVED

If well telescopes please sketch and show depths.

GROUND LEVEL

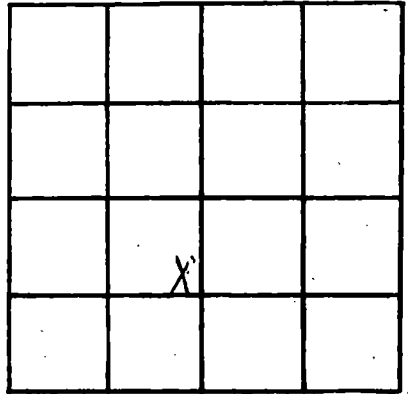

SECTION 6

Please indicate well location X.

ADDITIONAL INFORMATION

If more than one screen,
show locations of each on sketch.