

MISSISSIPPI DEPARTMENT OF NATURAL RESOURCES
Bureau of Land and Water Resources
 Southport Mall
 P.O. Box 10631
 Jackson, Mississippi 39209
WATER WELL DRILLERS LOG

Hancock
M 209
8-9 1984 Gulf Coast Waterwell Hancock
 date well completed firm name county well located

LANDOWNER: <u>NOLES MOUTER AND</u>	description of formations encountered	from	to
<u>ST-MARY ST</u>	<u>CLAY</u>	<u>-</u>	<u>15'</u>
<u>ANSLEY MISS</u> (mailing address)	<u>SAND</u>	<u>15</u>	<u>85</u>
WELL LOCATION:	<u>SANDY CLAY</u>	<u>85</u>	<u>120</u>
sec. <u>27</u> <u>9</u> <u>N</u> <u>R 15</u> <u>W</u> <u>S</u> <u>W</u>	<u>CLAY</u>	<u>120</u>	<u>140</u>
_____ miles _____ of _____ (distance) (direction) (nearest town)	<u>SAND - COURSE</u>	<u>140</u>	<u>170</u>
WELL PURPOSE: <u>CAMP</u> (home, irrigation, municipal, industrial)			
WELL COMPLETION DATA:			
(1) diameter (inches) <u>3</u>			
(2) total depth (feet) <u>170'</u>			
(3) static water level (feet) <u>8</u> below top of ground. above			
(4) casing <u>PVC</u> , <u>160</u> (material) (depth)			
_____ if telescope see back. (size)			
(5) screen <u>10'</u> , <u>160</u> (length) (depth to top)			
<u>2"</u> , <u>PVC</u> (size) (material)			
(6) pump _____ (HP) (yield gpm)			
_____ (type power)			
(7) electric log _____ (yes or no)			
_____ (organization running log)			
(8) how well bottom plugged <u>SAND SHARK</u>			

DEPT. OF NATURAL RESOURCES
 BUREAU OF LAND & WATER RESOURCES


SEP 13 1984

RECEIVED

DRILLERS REMARKS:

If well telescopes please sketch and show depths.

GROUND LEVEL

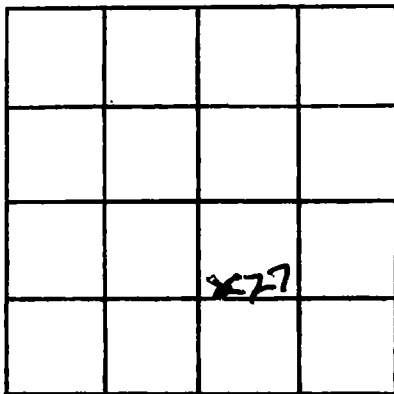

SECTION 2

Please indicate well location X.

ADDITIONAL INFORMATION

If more than one screen,
show locations of each on sketch.