

MISSISSIPPI DEPARTMENT OF NATURAL RESOURCES

Bureau of Land and Water Resources

Southport Mall

P.O. Box 10631

Jackson, Mississippi 39209

WATER WELL DRILLERS LOG

Hancock  
M 20907

8-16-1984 date well completed Wood Well Drg. firm name Hancock county well located

LANDOWNER: Julie Polk  
1 Xron Bay Estates  
Bay St. Louis, ms.  
(mailing address)

description of fomations encountered

from to

<u>Fill - clay</u>	<u>0</u>	<u>15</u>
<u>sd</u>	<u>15</u>	<u>32</u>
<u>clay</u>	<u>32</u>	<u>94</u>
<u>sd</u>	<u>94</u>	<u>120</u>
<u>clay</u>	<u>120</u>	<u>132</u>
<u>sd</u>	<u>132</u>	<u>150</u>

WELL LOCATION:

sec. 33 T 9 N R 15 E  
(S) (W)  
4 miles S/W of Ansley  
(distance) (direction) (nearest town)

WELL PURPOSE: Comp  
(home, irrigation, municipal, industrial)

WELL COMPLETION DATA:

- (1) diameter (inches) 2"
- (2) total depth (feet) 150'
- (3) static water level (feet) 5 <sup>below</sup> <sub>above</sub> top of ground.
- (4) casing PVC, 140  
(material) (depth)  
- if telescope see back.  
(size)
- (5) screen 10', -  
(length) (depth to top)  
2", PVC  
(size) (material)
- (6) pump orner, -  
(HP) (yield gpm)  
-  
(type power)
- (7) electric log NO  
(yes or no)  
N/A  
(organization running log)
- (8) how well bottom plugged BWV


DRILLERS REMARKS: N/A

DEPT. OF NATURAL RESOURCES  
BUREAU OF LAND & WATER RESOURCES

OCT 19 1984  
RECEIVED

If well telescopes please sketch and show depths.

GROUND LEVEL

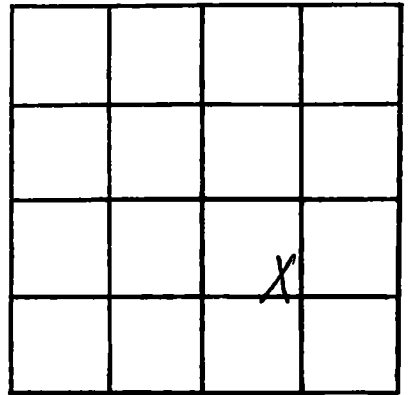

SECTION 33

Please indicate well location X.

ADDITIONAL INFORMATION

If more than one screen,  
show locations of each on sketch.