

MISSISSIPPI DEPARTMENT OF NATURAL RESOURCES

Bureau of Land and Water Resources

Southport Mall

P.O. Box 10631

Jackson, Mississippi 39209

WATER WELL DRILLERS LOG

HANCOCK  
M 2101

June 10 1985 date well completed  
85 Ward Well Dlg firm name  
Hancock county well located


LANDOWNER: James Venson  
West Bayou Rd.  
Anley, Mr.  
(mailing address)

description of formations encountered	from	to
Silt - clay	0	21
sd	21	32
clay	32	96
sd	96	120
clay - silt	120	136
sd - Red Mud	136	155

WELL LOCATION:  
sec. 34 T 9 N R 15 E  
S  
15 miles S/W of Lakehurst  
(distance) (direction) (nearest town)

WELL PURPOSE: Home  
(home, irrigation, municipal, industrial)

- WELL COMPLETION DATA:
- (1) diameter (inches) 2"
  - (2) total depth (feet) 155
  - (3) static water level (feet) 4 (below/above top of ground)
  - (4) casing PVC, 145,  
(material) (depth)  
- if telescope see back.  
(size)
  - (5) screen 10', -  
(length) (depth to top)  
2", PVC  
(size) (material)
  - (6) pump 1/2, 12  
(HP) (yield gpm)  
Elec.  
(type power)
  - (7) electric log NO  
(yes or no)  
N/A  
(organization running log)
  - (8) how well bottom plugged BWW

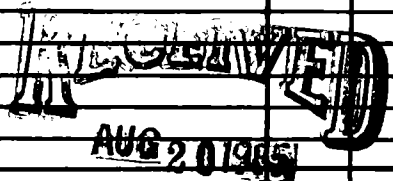


DRILLERS REMARKS: N/A

Department of Natural Resources  
Bureau of Land & Water Resources

If well telescopes please sketch and show depths.

GROUND LEVEL

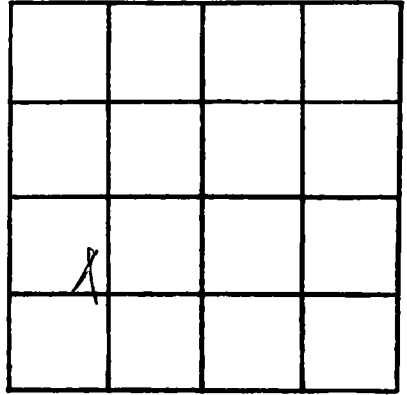

SECTION 34

Please indicate well location X.

ADDITIONAL INFORMATION

If more than one screen,  
show locations of each on sketch.