

MISSISSIPPI DEPARTMENT OF NATURAL RESOURCES

Bureau of Land and Water Resources

Southport Mall

P.O. Box 10631

Jackson, Mississippi 39209

WATER WELL DRILLERS LOG

HANCOCK  
M 2100

June 10 1985 date well completed  
85 Ward Well Dr. firm name  
Hancock county well located

LANDOWNER: Frank Eckert  
Heron Bay Estates  
Anchey  
(mailing address)

description of formations encountered	from	to
fill	0	3
clay	3	18
SD	18	35
clay - silt	35	104
SD	104	149

WELL LOCATION:  
sec. 27 T-9 N R-15 E  
14 miles S/W of Lakehurst  
(distance) (direction) (nearest town)

WELL PURPOSE: Camp  
(home, irrigation, municipal, industrial)

- WELL COMPLETION DATA:
- (1) diameter (inches) 2"
  - (2) total depth (feet) 149
  - (3) static water level (feet) 6 below top of ground
  - (4) casing PVC, 139 (material), (depth)  
If telescope see back.
  - (5) screen 10' (length), (depth to top)  
2" PVC (size), (material)
  - (6) pump 1/2 (HP), 10 (yield gpm)  
Elec (type power)
  - (7) electric log NO (yes or no)  
N/A (organization running log)
  - (8) how well bottom plugged BWV


DRILLERS REMARKS: N/A

RECEIVED  
AUG 20 1985

Department of Natural Resources  
Bureau of Land and Water Resources

If well telescopes please sketch and show depths.

GROUND LEVEL

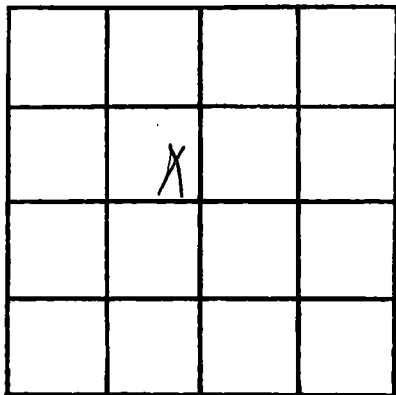

SECTION 27

Please indicate well location X.

ADDITIONAL INFORMATION

If more than one screen, show locations of each on sketch.