

MISSISSIPPI DEPARTMENT OF NATURAL RESOURCES

Bureau of Land and Water Resources

Southport Mall

P.O. Box 10631

Jackson, Mississippi 39209

WATER WELL DRILLERS LOG

Hancock
M 2100A

10-15
date well completed

1985 Ward Well Dr.
firm name

Hancock
county well located

LANDOWNER: J.E. Morrison
Rt. 2, Box 474
Bay St. Louis, ms.
(mailing address)

description of formations encountered	from	to
	<u>Clay</u>	<u>0</u>
<u>sd</u>	<u>11</u>	<u>31</u>
<u>Clay - Silt</u>	<u>31</u>	<u>94</u>
<u>Coal sd</u>	<u>94</u>	<u>114</u>

WELL LOCATION:
sec. 10 T. 9 N. R. 14 E.
12 miles S/W of Warland
(distance) (direction) (nearest town)

WELL PURPOSE: Home
(home, irrigation, municipal, industrial)

WELL COMPLETION DATA:

(1) diameter (inches) 2"

(2) total depth (feet) 114

(3) static water level (feet) 10 below top of ground.

(4) casing PVC, 104,
(material) (depth)
- if telescope see back.
(size)

(5) screen 10', -
(length) (depth to top)
2", PV
(size) (material)

(6) pump none, -
(HP) (yield gpm)
-
(type power)

(7) electric log NO
(yes or no)
N/A
(organization running log)

(8) how well bottom plugged BWD

DRILLERS REMARKS: N/A


RECEIVED

NOV 20 1985

Department of Natural Resources
Bureau of Land & Water Resources

If well telescopes please sketch and show depths.

GROUND LEVEL

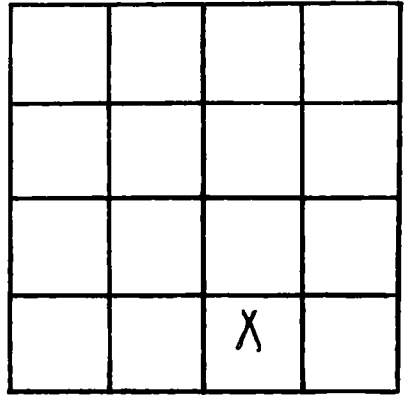

SECTION 10

Please indicate well location X.

ADDITIONAL INFORMATION

If more than one screen,
show locations of each on sketch.