

MISSISSIPPI DEPARTMENT OF NATURAL RESOURCES

Bureau of Land and Water Resources

Southport Mall

P.O. Box 10631

Jackson, Mississippi 39209

WATER WELL DRILLERS LOG

Hancock
M 2109

Oct. 10 1985 Ward Well Drg. Hancock
date well completed firm name county well located


LANDOWNER:	description of formations encountered	from	to
<u>Mr. Helme Gungor</u> <u>Orange St.</u> <u>Bay St. Louis, Mrs.</u> (mailing address)			
WELL LOCATION: <u>15</u> sec. <u>10</u> T. <u>9</u> N R. <u>14</u> E <u>12</u> miles <u>SW</u> of <u>Ward</u> (distance) (direction) (nearest town)			
WELL PURPOSE: <u>None</u> (home, irrigation, municipal, industrial)			
WELL COMPLETION DATA:			
(1) diameter (inches) <u>2"</u>			
(2) total depth (feet) <u>115</u>			
(3) static water level (feet) <u>10</u> <u>below</u> above top of ground.			
(4) casing <u>PVC</u> <u>105</u> (material) (depth) <u>-</u> if telescope see back. (size)			
(5) screen <u>10'</u> <u>-</u> (length) (depth to top) <u>2"</u> <u>PVC</u> (size) (material)			
(6) pump <u>Crown</u> <u>-</u> (HP) (yield gpm) <u>-</u> (type power)			
(7) electric log <u>NO</u> (yes or no) <u>N/A</u> (organization running log)			
(8) how well bottom plugged <u>BWV</u>			
DRILLERS REMARKS: <u>N/A</u>			

RECEIVED
NOV 20 1985

Department of Natural Resources
Bureau of Land & Water Resources

If well telescopes please sketch and show depths.

GROUND LEVEL

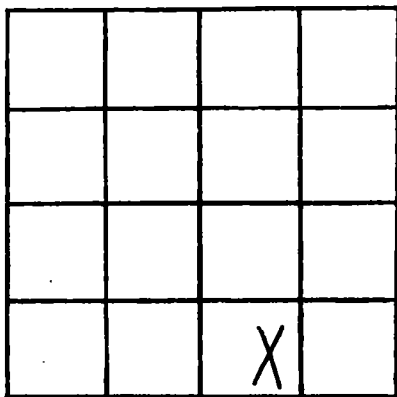

SECTION 10

Please indicate well location X.

ADDITIONAL INFORMATION

If more than one screen,
show locations of each on sketch.