

MISSISSIPPI DEPARTMENT OF NATURAL RESOURCES

Bureau of Land and Water Resources

Southport Mall

P.O. Box 10631

Jackson, Mississippi 39209

WATER WELL DRILLERS LOG

HANCOCK
M 2106

Jan. 13 1986 Ward Well Drg Hancock
date well completed firm name county well located

LANDOWNER Charles Duffy
West Forest St.
Bay St. Louis Mrs.
(mailing address)

WELL LOCATION:
sec. 6 T. 9 N. R. 14 E.
7 miles W of Waveland
(distance) (direction) (nearest town)

WELL PURPOSE: Home
(home, irrigation, municipal, industrial)

- WELL COMPLETION DATA:
- (1) diameter (inches) 2"
 - (2) total depth (feet) 165
 - (3) static water level (feet) 12 ^{below} above top of ground.
 - (4) casing PVC, 155,
(material) (depth)
- if telescope see back.
(size)
 - (5) screen 10', -
(length) (depth to top)
2", PVC
(size) (material)
 - (6) pump owner, -
(HP) (yield gpm)
-
(type power)
 - (7) electric log no,
(yes or no)
N/A
(organization running log)
 - (8) how well bottom plugged BWU

description of formations encountered	from	to
<u>fill - clay</u>	<u>0</u>	<u>12</u>
<u>clay</u>	<u>12</u>	<u>44</u>
<u>clay - shell</u>	<u>44</u>	<u>65</u>
<u>clay</u>	<u>65</u>	<u>84</u>
<u>clay</u>	<u>84</u>	<u>96</u>
<u>clay - shell</u>	<u>96</u>	<u>132</u>
<u>Red Shell - sh</u>	<u>132</u>	<u>148</u>
	<u>148</u>	<u>165</u>

RECEIVED


MAR 6 - 1986

Department of Natural Resources
Bureau of Land & Water Resources

DRILLERS REMARKS: N/A

If well telescopes please sketch and show depths.

GROUND LEVEL

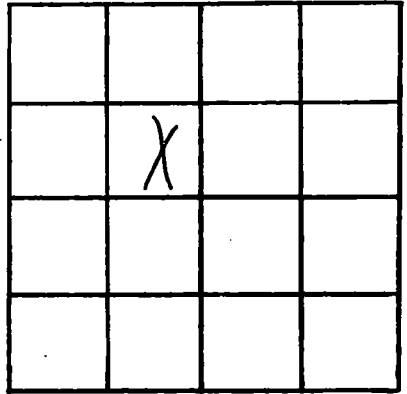

SECTION 6

Please indicate well location X.

ADDITIONAL INFORMATION

If more than one screen,
show locations of each on sketch.