

MISSISSIPPI DEPARTMENT OF NATURAL RESOURCES

Bureau of Land and Water Resources

Southport Mall

P.O. Box 10631

Jackson, Mississippi 39209

WATER WELL DRILLERS LOG

Hancock
M 2109

Mar 18 1986 Wood Well Drg Hancock
date well completed firm name county well located

LANDOWNER: Arthur Simpson
Corington St.
Bay St. Louis ms.
(mailing address)


description of formations encountered	from	to
<u>fill - clay</u>	<u>0</u>	<u>12</u>
<u>sd</u>	<u>12</u>	<u>45</u>
<u>clay - shell</u>	<u>45</u>	<u>96</u>
<u>sd</u>	<u>96</u>	<u>128</u>
<u>fill - clay</u>	<u>129</u>	<u>152</u>
<u>sd - Red gravel</u>		

WELL LOCATION:
sec. 6 T. 9 N R. 14¹⁵
13 miles W of B.S.L.
(distance) (direction) (nearest town)

WELL PURPOSE: Home
(home, irrigation, municipal, industrial)

- WELL COMPLETION DATA:
- (1) diameter (inches) 2"
 - (2) total depth (feet) 168'
 - (3) static water level (feet) 12 ^{below} above top of ground.
 - (4) casing PVC 158'
(material) (depth)
(size) If telescope see back.
 - (5) screen 10' -
(length) (depth to top)
2" PVC
(size) (material)
 - (6) pump Orinex -
(HP) (yield gpm)
(type power)
 - (7) electric log NO
(yes or no)
N/A
(organization running log)
 - (8) how well bottom plugged B.W.V.


DRILLERS REMARKS: N/A

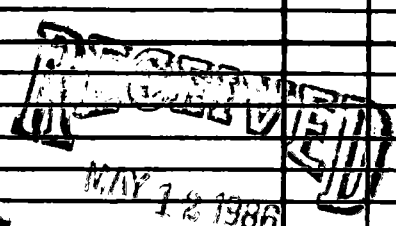

Department of Natural Resources
Bureau of Land & Water Resources

If well telescopes please sketch and show depths.

GROUND LEVEL

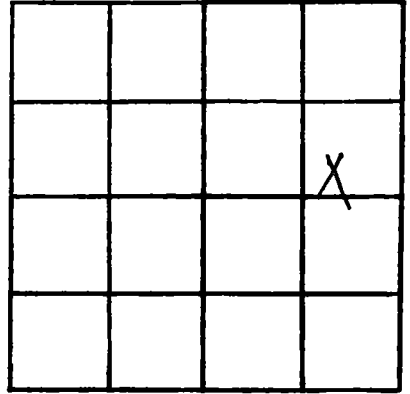

SECTION 6

Please indicate well location X.

ADDITIONAL INFORMATION

A series of horizontal lines for writing additional information, starting below the 'ADDITIONAL INFORMATION' header and extending to the bottom of the page.

If more than one screen, show locations of each on sketch.