

MISSISSIPPI DEPARTMENT OF NATURAL RESOURCES

Bureau of Land and Water Resources

Southport Mall

P.O. Box 10631

Jackson, Mississippi 39209

WATER WELL DRILLERS LOG

Hancock
M 2109B

April 24 1986 Ward Well Drg. Hancock
date well completed firm name county well located

LANDOWNER: Billy New
Hevon Bay Estate
Bay St. Louis, Ms.
(mailing address)

description of formations encountered	from	to
	<u>fill clay</u>	<u>0</u>
<u>clay</u>	<u>3</u>	<u>12</u>
<u>sd</u>	<u>12</u>	<u>16</u>
<u>clay</u>	<u>16</u>	<u>85</u>
<u>sd</u>	<u>85</u>	<u>96</u>
<u>clay - silt</u>	<u>96</u>	<u>110</u>
<u>sea sand - sd</u>	<u>110</u>	<u>150</u>

WELL LOCATION:
sec. 4 T. 10 N R. 15 E
10 miles s/w of Lakehurst
(distance) (direction) (nearest town)

WELL PURPOSE: camp
(home, irrigation, municipal, industrial)

- WELL COMPLETION DATA:
- (1) diameter (inches) 2"
 - (2) total depth (feet) 150'
 - (3) static water level (feet) 4 ^{below} above top of ground.
 - (4) casing PVC 140
(material) (depth)
- (size) if telescope see back.
 - (5) screen 10' -
(length) (depth to top)
2" PVC
(size) (material)
 - (6) pump owner -
(HP) (yield gpm)
- (type power)
 - (7) electric log NO
(yes or no)
N/A
(organization running log)
 - (8) how well bottom plugged BWD

DRILLERS REMARKS: N/A


RECEIVED

JUN 27 1986

Department of Natural Resources
Bureau of Land & Water Resources

If well telescopes please sketch and show depths.

GROUND LEVEL

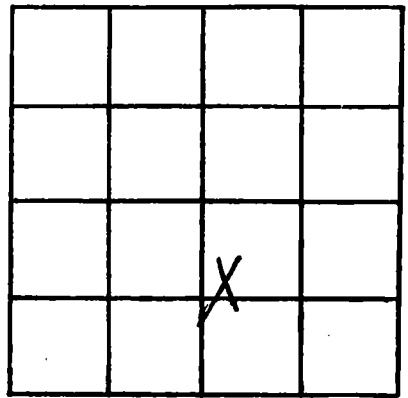

SECTION 4

Please indicate well location X.

ADDITIONAL INFORMATION

Lined area for additional information.

If more than one screen, show locations of each on sketch.