

Hancock
M 21109

MISSISSIPPI DEPARTMENT OF NATURAL RESOURCES
Bureau of Land and Water Resources
Southport Mall
P.O. Box 10631
Jackson, Mississippi 39209
WATER WELL DRILLERS LOG

April 30 1986 Ward Well Dr. Hancock
Date well completed firm name county well located

LANDOWNER: Carl P. Sattu
Sot 861 - West Gulf Road
Bay St. Louis, Ms.
(mailing address)

description of formations encountered	from	to
<u>fill - sd</u>	<u>0</u>	<u>16</u>
<u>clay</u>	<u>16</u>	<u>58</u>
<u>cl sd</u>	<u>58</u>	<u>80</u>
<u>clay</u>	<u>80</u>	<u>100</u>
<u>sd</u>	<u>100</u>	<u>164</u>
<u>clay</u>	<u>104</u>	<u>123</u>
<u>Red Shell - sd</u>	<u>123</u>	<u>170</u>

WELL LOCATION:
sec. 4 T. 10 N. R. 15 E
10 miles S/W of Sabine
(distance) (direction) (nearest town)

WELL PURPOSE: Home
(home, irrigation, municipal, industrial)

- WELL COMPLETION DATA:
- (1) diameter (inches) 2"
 - (2) total depth (feet) 170'
 - (3) static water level (feet) 6 ^{below} _{above} top of ground.
 - (4) casing PVC, 160,
(material) (depth)
- if telescope see back.
(size)
 - (5) screen 10', -
(length) (depth to top)
2", PVC
(size) (material)
 - (6) pump owner -
(HP) (yield gpm)
- (type power)
 - (7) electric log NO
(yes or no)
N/A
(organization running log)
 - (8) how well bottom plugged BWD

RECEIVED


JUN 27 1986

Department of Natural Resources
Bureau of Land & Water Resources

DRILLERS REMARKS: Well was
Cement grouted for
0-10 feet.

If well telescopes please sketch and show depths.

GROUND LEVEL

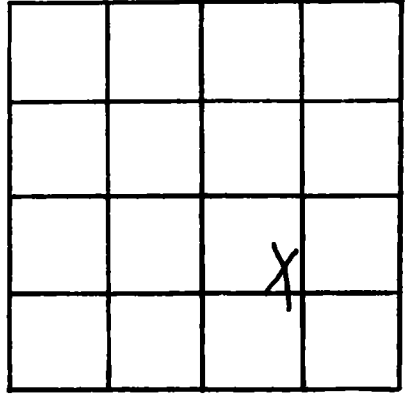

SECTION _____

Please indicate well location X.

ADDITIONAL INFORMATION

If more than one screen, show locations of each on sketch.