

MISSISSIPPI DEPARTMENT OF NATURAL RESOURCES

Bureau of Land and Water Resources

Southport Mall

P.O. Box 10631

Jackson, Mississippi 39209

WATER WELL DRILLERS LOG

Hancock
M 2110

Sept. 12 1986 Ward Well Drg Hancock  
 date well completed firm name county well located

LANDOWNER: Paul Richard  
 Heron Bay Est.  
 Anselby Mrs.  
 (mailing address)

description of formations encountered	from	to
	Fill - clay	0
sd	18	54
clay -	54	86
sd	86	135
clay	135	138
Red gravel - sd	138	160

WELL LOCATION:  
 sec. 34 T 9 N R 15 E  
 2 miles S of Anselby  
 (distance) (direction) (nearest town)

WELL PURPOSE: None  
 (home, irrigation, municipal, industrial)

- WELL COMPLETION DATA:
- (1) diameter (inches) 2"
  - (2) total depth (feet) 160
  - (3) static water level (feet) 6 below above top of ground
  - (4) casing PUC 150 (material) (depth)  
 2 (size) If telescope see back.
  - (5) screen 10' (length) (depth to top)  
 2" PUC (size) (material)
  - (6) pump none (HP) (yield gpm)  
 (type power)
  - (7) electric log no (yes or no)  
 N/A (organization running log)
  - (8) how well bottom plugged BWV

DRILLERS REMARKS: N/A


RECEIVED

NOV 14 1986

Department of Natural Resources  
 Bureau of Land & Water Resources

If well telescopes please sketch and show depths.

GROUND LEVEL

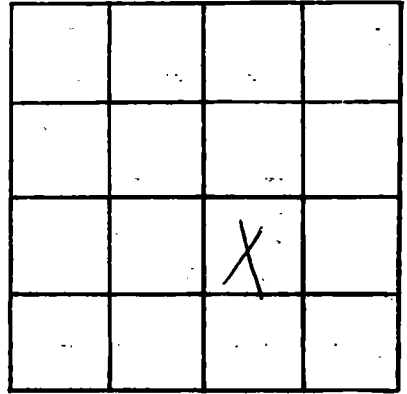

SECTION 34

Please indicate well location. X.

ADDITIONAL INFORMATION

Lined area for additional information.

If more than one screen, show locations of each on sketch.