

MISSISSIPPI DEPARTMENT OF NATURAL RESOURCES
Bureau of Land and Water Resources

P.O. Box 10631

Jackson, Mississippi 39209

WATER WELL DRILLERS LOG

COUNTY WELL LOCATED <i>Hancock</i>	
WELL NUMBER <i>M 2112</i>	CODED
DATE WELL COMPLETED <i>Sept. 2, 1987</i>	

PERMIT NUMBER
NAME OF DRILLING FIRM <i>Ward Well Dlg.</i>
<i>At. 2 Box 350C, B.S.L., ms.</i>

NAME & MAILING ADDRESS OF LANDOWNER <i>Rennie Planché</i>		
<i>570 East Marlin St.</i>		
<i>Bay St. Louis ms.</i>		
WELL LOCATION: SEC	TOWNSHIP	RANGE
<i>33</i>	<i>9</i>	<i>15</i>
DISTANCE	DIRECTION	NEAREST TOWN
<i>3</i> Miles	<i>S/W</i> of	<i>oreley</i>
OTHER LANDMARK <i>Heum Bay Estate</i>		
WELL PURPOSE: Home, Irrigation, Municipal, Industrial, Fish Pond, etc. <i>Home</i>		

PUMP DATA		
PUMP TYPE (Circle One): Submersible, Turbine, Jet, Flowing Well, Other (Describe) <u><i>runner</i></u>		
POWER TYPE (Circle One): Electric, Tractor, Diesel, Gasoline, Butane, Other (Describe) _____		
Pump Capacity (GPM)	No. of Stages	Setting Depth FT.
PUMP TEST		
Well yielded _____ GPM with a drawdown of _____ ft. after _____ hours of pumping		

WELL DATA		
Well Depth <i>150 ft.</i>	Casing Diameter (In.) <i>2"</i>	Casing Length (Ft.) <i>140 ft.</i>
Type of Casing <i>8k, 40 pc</i>	Hole Depth <i>150 ft.</i>	Depth to Static Water Level <i>- 10 ft.</i>
TYPE OF COMPLETION (Circle One or More): Gravel Packed, Underreamed, Telescoped, Natural Development, Open Hole, <u><i>Other</i></u> (Describe) <i>Back wash - air</i>		
Top of Lap Pipe or Reduction in Casing FEET IF TELESCOPED OR MORE THAN ONE SCREEN: USE BACK PAGE		

LOG DATA	
TYPE OF LOG RUN (Circle One): Electric, Gamma Ray, Density, Sonic, <u><i>No Log Run</i></u> , Neutron, Other (Describe) _____	
Name of Organization Running Log	

SCREEN DATA		
Diameter - Inches <i>2"</i>	Length - Feet <i>10 ft.</i>	Slot Size - Inches <i>.008</i>
Screen Type <i>Sch. 80 p/c</i>	Depth to Bottom - Feet <i>- 150</i>	

GEOLOGIC DATA (Office Use Only)			
Surface Elev.	Geologic Unit	Unit Thickness	Depth to Top
Subs. SWL	Date	Analysis	Aquifer Test


Driller's Remarks

DESCRIPTION OF FORMATIONS ENCOUNTERED	FROM	TO
<i>fill - clay</i>	<i>0</i>	<i>18</i>
<i>sd</i>	<i>18</i>	<i>36</i>
<i>clay</i>	<i>36</i>	<i>75</i>
<i>sd</i>	<i>75</i>	<i>90</i>
<i>clay-silt</i>	<i>90</i>	<i>126</i>
<i>Coarse sd - limestone</i>	<i>126</i>	<i>150</i>

RECEIVED		
FORMATIONS (Continued)	FROM	TO
<i>MTW 13 1987</i>		
Department of Natural Resources Bureau of Land & Water Resources		
IF MORE SPACE IS NEEDED, USE BACK		

If well telescopes please sketch and show depths.

GROUND LEVEL

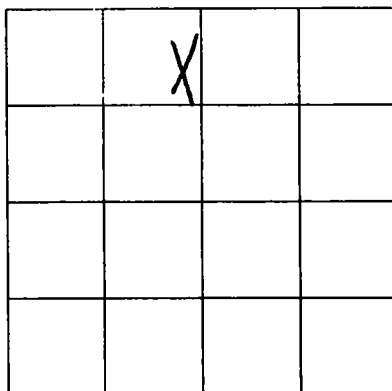

SECTION 33

Please indicate well location X.

ADDITIONAL INFORMATION

If more than one screen,
show location of each on sketch.