

MISSISSIPPI DEPARTMENT OF NATURAL RESOURCES
Bureau of Land and Water Resources
 Southport Mall
 P.O. Box 10631
 Jackson, Mississippi 39209
WATER WELL DRILLERS LOG

Hancock
KA 2116

29 Aug. 1983 Ward Well Drg. Hancock
 date well completed firm name county well located

LANDOWNER: Willie Beckwith
Huron Bay Estates
Analby, Mrs.
 (mailing address)

| description of formations encountered | from | to |
|---------------------------------------|------------|------------|
| <u>Fill - clay</u> | <u>0</u> | <u>15</u> |
| <u>sd</u> | <u>15</u> | <u>43</u> |
| <u>clay</u> | <u>43</u> | <u>95</u> |
| <u>sc</u> | <u>95</u> | <u>116</u> |
| <u>clay</u> | <u>116</u> | <u>130</u> |
| <u>sd - Red gravel</u> | <u>130</u> | <u>150</u> |

WELL LOCATION:
 sec. 33 T 9 N R. 15 E
5 1/2 miles S/W of Analby
 (distance) (direction) (nearest town)

WELL PURPOSE:
 (home, irrigation, municipal, industrial)

- WELL COMPLETION DATA:
- (1) diameter (inches) 2"
 - (2) total depth (feet) 150
 - (3) static water level (feet) 2 below top of ground above
 - (4) casing PVC, 1 1/2
 (material) (depth)
 (size) if telescope see back.
 - (5) screen 10' (length) (depth to top)
2" (size) 10' (material)
 - (6) pump owner (HP) (yield gpm)
 (type power)
 - (7) electric log NO (yes or no)
N/A (organization running log)
 - (8) how well bottom plugged BWU

DRILLERS REMARKS: N/A


DEPT. OF NATURAL RESOURCES
 BUREAU OF LAND & WATER RESOURCES

OCT 17 1983

RECEIVED

If well telescopes please sketch and show depths.

GROUND LEVEL

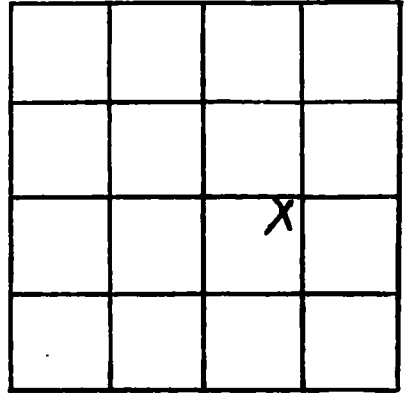

SECTION 33

Please indicate well location X.

ADDITIONAL INFORMATION

If more than one screen, show locations of each on sketch.