

MISSISSIPPI DEPARTMENT OF NATURAL RESOURCES
 Bureau of Land and Water Resources
 Southport Mall
 P.O. Box 10631
 Jackson, Mississippi 39209
WATER WELL DRILLERS LOG

Hancock
~~M 2~~
 2117

6-21

date well completed

1984 Ward Well Drg.

firm name

Hancock

county well located

LANDOWNER: August F. Wicker Jr.

description of formations encountered

from to

Rt. 2, Box 346

Clay

0 12

Bay St. Louis, mi.
 (mailing address)

sd

12 42

WELL LOCATION:

15

sec. 8 T. 9 N. R. 14 E.

Clay

42 105

7 miles S/W of Waukegan
 (distance) (direction) (nearest town)

sd

105 131

Clay-Silt

131 198

sd

198 220

Clay-Silt

220 278

Clay sd

278 315

WELL PURPOSE:

(home, irrigation, municipal, industrial)

WELL COMPLETION DATA:

(1) diameter (inches) 2"
 (2) total depth (feet) 315
 (3) static water level (feet) 12 ^{below} ~~above~~ top of ground.

(4) casing PUC, 305.
 (material) (depth)
 (size) if telescope see back.

(5) screen 10', -
 (length) (depth to top)
 2" PUC
 (size) (material)

(6) pump - -
 (HP) (yield gpm)
 (type power)

(7) electric log NO
 (yes or no)
 N/A
 (organization running log)

(8) how well bottom plugged BWV

DEPT. OF NATURAL RESOURCES
 BUREAU OF LAND & WATER RESOURCES


AUG 3 1984

RECEIVED

DRILLERS REMARKS: N/A

If well telescopes please sketch and show depths.

GROUND LEVEL

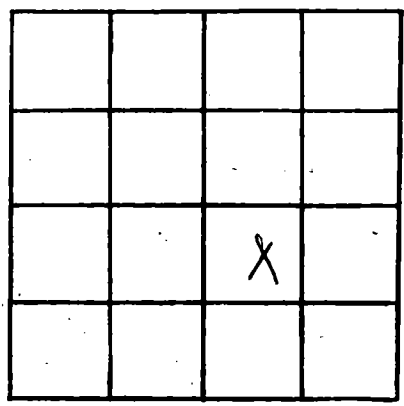

SECTION 8

Please indicate well location X.

ADDITIONAL INFORMATION

Lined area for additional information.

If more than one screen, show locations of each on sketch.