

HANCOCK

MISSISSIPPI BOARD OF WATER COMMISSIONERS

M ~~2029~~ 2118

8-27-65

WATER WELL DRILLERS LOG

Date: 8-27, 19 65, Driller: Little Well Works County Hancock

(Name)

(1) Owner of Land: Clarence Moran
(Name)
Lakeview Miss.
(Address)

(2) Location: SE 1/4, SE 1/4, Sec. 12 T9S R15W
1 miles N of Lakeview
(distance) (direction) (Nearest Town)

(3) Topography: flat
(Hilly) (Flat) (Level)

(4) Purpose of Well: domestic home
(Domestic Irrigation
Municipal, Industrial, Other)

Description & Color of Materials Sand, Clay, Red Clay, Shell, etc.	Thick- ness Feet	Depth Feet
Clay	7	7
sand	37	44
clay	62	106
sand	20	126
clay	36	162
sand / gravel	12	174
Clay - sand streaks	88	262
sand	33	295

Information upon completion of well:

(1) Diameter 2 inches.

(2) Total Depth 295 feet.

(3) Water Level 6 feet below top of ground. 285

(4) Cased to cell, Size 2"


(5) Screen: Size 2", Length 10'

(6) Were any formations sealed against pollution?
_____ yes, no.

If YES depth of formation _____

Why _____

Drillers Remarks: _____

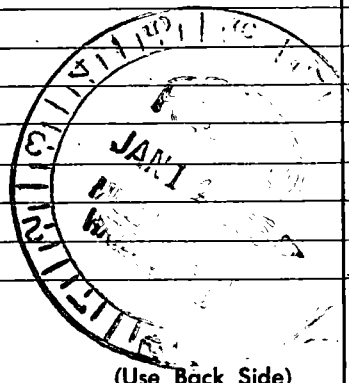

(Use Back Side)

Well No.

Jan 15 Animal ...

100 100
100 100
100

100

