

M ~~7030~~ 2119

8-30-65

WATER WELL DRILLERS LOG

Date: 8-30, 1965, Driller: Sutter Well Works Wakar County, Hancock
 (Name)

(1) Owner of Land: <u>Tommy Mayne</u> (Name)	Description & Color of Materials Sand, Clay, Red Clay, Shell, etc.	Thick- ness Feet	Depth Feet
<u>1020 Derpichow St., New Orleans, La.</u> (Address)	Clay	10	10
(2) Location <u>N 1/4, SE 1/4, Sec. 12, T95R13W</u>	Sand	47	57
<u>2</u> miles <u>N</u> of <u>Lakeside</u> (distance) (direction) (Nearest Town)	Clay	39	96
(3) Topography: <u>flat</u> (Hilly) (Flat) (Level)	Sand	29	125
(4) Purpose of Well: <u>domestic Home</u> (Domestic Irrigation Municipal, Industrial, Other)	Clay	55	180
	Sand	35	215


Information upon completion of well:

- (1) Diameter 2 inches.
- (2) Total Depth 215 feet.
- (3) Water Level 8 feet below top of ground.
- (4) Cased to top, Size 2".
- (5) Screen: Size 2", Length 5'.
- (6) Were any formations sealed against pollution?
 yes, no.

If YES depth of formation surface

Why _____

Drillers Remarks: _____

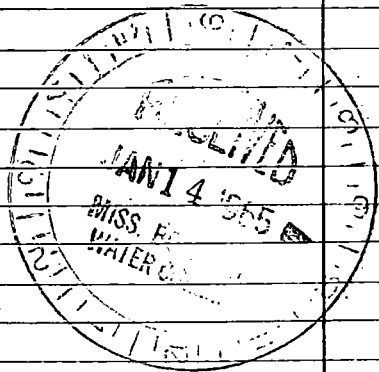

(Use Back Side)

Well No.

Handwritten text at the top right corner, possibly a name or date.

Main header or title line, appearing to be a mix of letters and numbers.

Table with multiple columns and rows of data, including numerical values and possibly names.

Text label or section header located in the lower middle part of the page.

Text label or section header located in the lower right part of the page.

Text label or section header located in the lower right part of the page.

Text label or section header located in the lower right part of the page.

Text label or section header located in the lower middle part of the page.